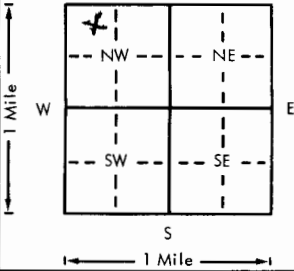
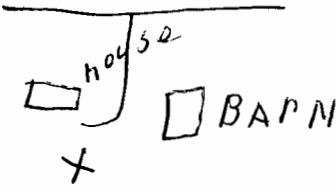


USE TYPEWRITER OR BALL POINT PEN-PRESS FIRMLY, PRINT CLEARLY.

WATER WELL RECORD
KSA 82a-1201-1215

Kansas Department of Health and Environment-Division of Environment (Water well Contractors) Topeka, Kansas 66620

<input checked="" type="checkbox"/> Location of well:	County Franklin	Fraction NE 1/4 NW 1/4 NW 1/4	Section number 35	Township number T 16 S R 18 E	Range number																					
<input checked="" type="checkbox"/> Distance and direction from nearest town or city: IN NW RICHTER KANS Street address of well location if in city:			3. Owner of well: Otto Schroeder R.R. or street: RRL City, state, zip code: Pomona, Kan., 66076																							
4. Locate with "X" in section below: 		Sketch map: 		6. Bore hole dia. 6 1/2 in. Completion date 5-10-78 Well depth 90 ft. 9' to 25'																						
5. Type and color of material		<table border="1" style="width:100%; border-collapse: collapse;"> <thead> <tr> <th></th> <th>From</th> <th>To</th> </tr> </thead> <tbody> <tr> <td>soil & clay</td> <td>0</td> <td>10</td> </tr> <tr> <td>yellow sand rock</td> <td>10</td> <td>22</td> </tr> <tr> <td>yellow sand rock</td> <td>22</td> <td>47</td> </tr> <tr> <td>brown sand rock</td> <td>47</td> <td>60</td> </tr> <tr> <td>grey sand</td> <td>60</td> <td></td> </tr> <tr> <td>white sand</td> <td></td> <td></td> </tr> </tbody> </table>			From	To	soil & clay	0	10	yellow sand rock	10	22	yellow sand rock	22	47	brown sand rock	47	60	grey sand	60		white sand			7. <input checked="" type="checkbox"/> Cable tool <input type="checkbox"/> Rotary <input type="checkbox"/> Driven <input type="checkbox"/> Dug <input type="checkbox"/> Hollow rod <input type="checkbox"/> Jetted <input type="checkbox"/> Bored <input type="checkbox"/> Reverse rotary	
					From	To																				
soil & clay	0	10																								
yellow sand rock	10	22																								
yellow sand rock	22	47																								
brown sand rock	47	60																								
grey sand	60																									
white sand																										
8. Use: <input checked="" type="checkbox"/> Domestic <input type="checkbox"/> Public supply <input type="checkbox"/> Industry <input type="checkbox"/> Irrigation <input type="checkbox"/> Air conditioning <input type="checkbox"/> Stock <input type="checkbox"/> Lawn <input type="checkbox"/> Oil field water <input type="checkbox"/> Other		9. Casing: Material _____ Height: Above or below _____ Threaded _____ Welded _____ Surface 18 in. RMP _____ PVC <input checked="" type="checkbox"/> Weight sch 40 lbs./ft. Dia. 6 1/2 in. to 2 1/2 ft. depth Wall Thickness: inches or Dia. _____ in. to _____ ft. depth gage No. sch 40																								
(Use a second sheet if needed)		10. Screen: Manufacturer's name _____ Type none Dia. _____ Slot/gauze _____ Length _____ Set between _____ ft. and _____ ft. _____ ft. and _____ ft. Gravel pack? no Size range of material _____		11. Static water level: _____ mo./day/yr. 10 ft. below land surface Date 5-78																						
				12. Pumping level below land surfaces: _____ ft. after _____ hrs. pumping _____ g.p.m. _____ ft. after _____ hrs. pumping _____ g.p.m. Estimated maximum yield 15 g.p.m.																						
18. Elevation: Topography: <input type="checkbox"/> Hill <input type="checkbox"/> Slope <input checked="" type="checkbox"/> Upland <input type="checkbox"/> Valley		19. Remarks: The farm does not have a septic tank at is time and there isnt any cattle		13. Water sample submitted: _____ mo./day/yr. <input type="checkbox"/> Yes <input checked="" type="checkbox"/> No Date _____																						
				14. Well head completion: PUMSE HOUSE <input type="checkbox"/> Pitless adapter _____ Inches above grade																						
20. Water well contractor's certification: This well was drilled under my jurisdiction and this report is true to the best of my knowledge and belief. EDGAR SWANK DRILLING, INC. Business name License No. _____ Address R4 OTTAWA KAN 66072 Signed Edgar Swank Date 8-20-78 Authorized representative		15. Well grouted? <input checked="" type="checkbox"/> With: <input checked="" type="checkbox"/> Neat cement <input type="checkbox"/> Bentonite <input type="checkbox"/> Concrete Depth: From 0 ft. to 12 ft.		16. Nearest source of possible contamination: ft. 50 Direction E Type BARN Well disinfected upon completion? <input checked="" type="checkbox"/> Yes <input type="checkbox"/> No																						
				17. Pump: _____ Not installed Manufacturer's name Red Jacket Model number 33n6BC HPL/3 Volts 110 Length of drop pipe 80 ft. capacity 10 g.p.m. Type: <input checked="" type="checkbox"/> Submersible <input type="checkbox"/> Turbine <input type="checkbox"/> Jet <input type="checkbox"/> Reciprocating <input type="checkbox"/> Centrifugal <input type="checkbox"/> Other																						

Forward the white, blue and pink copies to the Department of Health and Environment

Form WWC-5

T 16 S R 18 E
 Sec 35
 NE 1/4 NW 1/4