

CORRECTION(S) TO WATER WELL RECORD (WWC-5)

(to rectify lacking or incorrect information)

County: Franklin

Location listed as:

Section-Township-Range: 19-185-16E

Fraction ($\frac{1}{4}$ $\frac{1}{4}$ $\frac{1}{4}$): SE cor SW SW

Location changed to:

19-165-18E

SE SW SW

Other changes: Initial statements: _____

Changed to: _____

Comments: _____

verification method: Written & legal descriptions, and

Pomona & Ottawa NW 1:24,000 topo. maps (buildings shown
on map) initials: ARL date: 6/9/2005

submitted by: Kansas Geological Survey, Data Resources Library, 1930 Constant Ave., Lawrence, KS 66047-3726


to: Kansas Dept of Health & Environment, Bureau of Water, 1000 SW Jackson, Suite 420, Topeka, KS 66612-1367.

1 LOCATION OF WATER WELL: Fraction SE cor 1/4 SW 1/4 SW 1/4 Section Number 19 Township Number T 18 S Range Number R 16 EW

Distance and direction from nearest town or city street address of well if located within city?
2 miles north, 3/4 west of Pomona

2 WATER WELL OWNER: Joni Murphy
RR#, St. Address, Box # : 531 Pawnee Rd. Board of Agriculture, Division of Water Resources
City, State, ZIP Code : Pomona, KS 66076 Application Number:

3 LOCATE WELL'S LOCATION WITH AN "X" IN SECTION BOX:

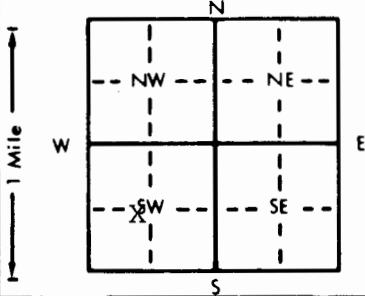

4 DEPTH OF COMPLETED WELL: 280' ft. ELEVATION:
Depth(s) Groundwater Encountered 1. ft. 2. ft. 3. ft.
WELL'S STATIC WATER LEVEL: 195' ft. below land surface measured on mo/day/yr 1/29/98
Pump test data: Well water was ft. after hours pumping gpm
Est. Yield 10 gpm: Well water was ft. after hours pumping gpm
Bore Hole Diameter 8 3/4 in. to ft., and in. to ft.
WELL WATER TO BE USED AS:
1 Domestic 3 Feedlot 6 Oil field water supply 9 Dewatering 12 Other (Specify below)
2 Irrigation 4 Industrial 7 Lawn and garden only 10 Monitoring well
Was a chemical/bacteriological sample submitted to Department? Yes No X; If yes, mo/day/yr sample was submitted
Water Well Disinfected? Yes X No

5 TYPE OF BLANK CASING USED:
1 Steel 3 RMP (SR) 5 Wrought iron 8 Concrete tile CASING JOINTS: Glued X Clamped
2 PVC 4 ABS 6 Asbestos-Cement 9 Other (specify below) Welded
7 Fiberglass Threaded

Blank casing diameter 5" in. to 0-230 ft., Dia. in. to ft., Dia. in. to ft.
Casing height above land surface 24" in., weight 2.82 lbs./ft. Wall thickness or gauge No. 258

TYPE OF SCREEN OR PERFORATION MATERIAL:
1 Steel 3 Stainless steel 5 Fiberglass 7 PVC 10 Asbestos-cement
2 Brass 4 Galvanized steel 6 Concrete tile 8 RMP (SR) 11 Other (specify)
12 None used (open hole)

SCREEN OR PERFORATION OPENINGS ARE:
1 Continuous slot 3 Mill slot 5 Gauzed wrapped 8 Saw cut 11 None (open hole)
2 Louvered shutter 4 Key punched 6 Wire wrapped 9 Drilled holes
7 Torch cut 10 Other (specify)

SCREEN-PERFORATED INTERVALS: From 230 ft. to 280 ft., From ft. to ft.
GRAVEL PACK INTERVALS: From 24 ft. to 280 ft., From ft. to ft.

6 GROUT MATERIAL: 1 Neat cement 2 Cement grout 3 Bentonite 4 Other
Grout Intervals: From 4 ft. to 24 ft., From ft. to ft., From ft. to ft.

What is the nearest source of possible contamination:
1 Septic tank 4 Lateral lines 7 Pit privy 10 Livestock pens 14 Abandoned water well
2 Sewer lines 5 Cess pool 8 Sewage lagoon 11 Fuel storage 15 Oil well/Gas well
3 Watertight sewer lines 6 Seepage pit 9 Feedyard 12 Fertilizer storage 16 Other (specify below)
13 Insecticide storage

Direction from well? west How many feet? 280'

FROM	TO	LITHOLOGIC LOG	FROM	TO	PLUGGING INTERVALS
0	3	Clay-Brown	106	114	Shaley LS-Grey
3	6	Limestone-Yellow	114	119	Limestone-Grey
6	13	Shale-Yellow	119	125	Shaley LS-Grey
13	34	Shale-Grey	125	129	Limestone-Grey
34	53	Limestone-Grey	129	139	Shaley LS-Grey
53	62	Shale-Black	139	140	Limestone-Grey
62	64	Limestone-Grey	140	205	Shale-Grey
64	65	Shale-Grey	205	230	Sandy Shale-Grey
65	66	Limestone-Grey	230	265	Sandstone-Grey
66	70	Shale-Grey	265	280	Shale-Grey
70	76	Limestone-Grey			
76	93	Sandy Shale-Grey			
93	98	Limestone-Grey			
98	102	Shale-Grey			
102	106	Limestone-Grey			

7 CONTRACTOR'S OR LANDOWNER'S CERTIFICATION: This water well was (1) constructed, (2) reconstructed, or (3) plugged under my jurisdiction and was completed on (mo/day/year) 1/29/98 and this record is true to the best of my knowledge and belief. Kansas Water Well Contractor's License No. 182 This Water Well Record was completed on (mo/day/yr) 2-14-98 under the business name of STRADER DRILLING CO., INC. by (signature) Dale Skren

OFFICE USE ONLY T R EAW SEC. 1/4 1/4 1/4