


1 LOCATION OF WATER WELL: Fraction SW 1/4 SW 1/4 SE 1/4 Section Number 34 Township Number T 16 S Range Number R 18 E
 County: Franklin

Distance and direction from nearest town or city street address of well if located within city?
2.6 miles East on K-68 from Pomona and 1.5 mile N.

2 WATER WELL OWNER: Lester Caleb
 RR#, St. Address, Box #: 1220 K-68 Hwy Board of Agriculture, Division of Water Resources
 City, State, ZIP Code: Pomona, KS. 66076 Application Number:

3 LOCATE WELL'S LOCATION WITH AN "X" IN SECTION BOX:

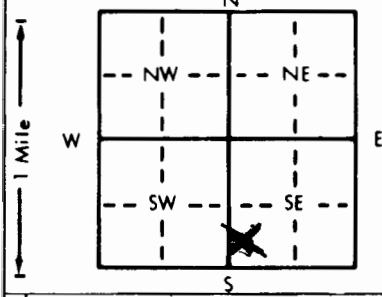

4 DEPTH OF COMPLETED WELL: 120 ft. ELEVATION:
 Depth(s) Groundwater Encountered 1. 68-92 ft. 2. ft. 3. ft.
 WELL'S STATIC WATER LEVEL 17 ft. below land surface measured on mo/day/yr 10-11-94
 Pump test data: Well water was ft. after hours pumping gpm
 Est. Yield 20 gpm; Well water was ft. after hours pumping gpm
 Bore Hole Diameter: 8 3/4 in. to 20 ft., and 7 7/8 in. to 120 ft.
 WELL WATER TO BE USED AS: 5 Public water supply 8 Air conditioning 11 Injection well
 1 Domestic 3 Feedlot 6 Oil field water supply 9 Dewatering 12 Other (Specify below)
 2 Irrigation 4 Industrial 7 Lawn and garden only 10 Monitoring well
 Was a chemical/bacteriological sample submitted to Department? Yes No; If yes, mo/day/yr sample was submitted
 Water Well Disinfected? Yes No

5 TYPE OF CASING USED: 5 Wrought iron 8 Concrete tile CASING JOINTS: Glued Clamped
 2 PVC 3 RMP (SR) 6 Asbestos-Cement 9 Other (specify below) Welded
 1 Steel 4 ABS 7 Fiberglass Threaded

Blank casing diameter 5 1/2 in. to 110 ft. Dia. in. to ft. Dia. in. to ft.
 Casing height above land surface 30 in. weight lbs./ft. Wall thickness or gauge No. 200#

TYPE OF SCREEN OR PERFORATION MATERIAL: 7 PVC 10 Asbestos-cement
 1 Steel 3 Stainless steel 5 Fiberglass 8 RMP (SR) 11 Other (specify)
 2 Brass 4 Galvanized steel 6 Concrete tile 9 ABS 12 None used (open hole)

SCREEN OR PERFORATION OPENINGS ARE: 5 Gauzed wrapped 8 Saw cut 11 None (open hole)
 1 Continuous slot 3 Mill slot 6 Wire wrapped 9 Drilled holes
 2 Louvered shutter 4 Key punched 7 Torch cut 10 Other (specify)

SCREEN-PERFORATED INTERVALS: From 110 ft. to 120 ft. From ft. to ft.
 GRAVEL PACK INTERVALS: From 120 ft. to 75 ft. From 55 ft. to 20 ft.

6 GROUT MATERIAL: 1 Neat cement 2 Cement grout 3 Bentonite 4 Other
 Grout Intervals: From 55 ft. to 75 ft. From 20 ft. to 0 ft. From ft. to ft.

What is the nearest source of possible contamination: None at the time
 1 Septic tank 4 Lateral lines 7 Pit privy 10 Livestock pens 14 Abandoned water well
 2 Sewer lines 5 Cess pool 8 Sewage lagoon 11 Fuel storage 15 Oil well/Gas well
 3 Watertight sewer lines 6 Seepage pit 9 Feedyard 12 Fertilizer storage 16 Other (specify below)
 13 Insecticide storage

Direction from well? How many feet?

FROM	TO	LITHOLOGIC LOG	FROM	TO	PLUGGING INTERVALS
0	18	Soil + Sand - yellow			
18	64	Shale			
64	68	Sand + Shale			
68	92	Sand - Large grained			
92	120	Sand + shale			

7 CONTRACTOR'S OR LANDOWNER'S CERTIFICATION: This water well was (1) constructed (2) reconstructed, or (3) plugged under my jurisdiction and was completed on (mo/day/year) 10-11-94 and this record is true to the best of my knowledge and belief. Kansas Water Well Contractor's License No. 561 This Water Well Record was completed on (mo/day/yr) 10-11-94 under the business name of EVANS ENERGY Dev. Inc. by signature Scott G. Evans