


1 LOCATION OF WATER WELL: County: Franklin Fraction: SW 1/4 SW 1/4 NE 1/4 Section Number: 3 Township Number: T 16 S Range Number: R 19 EW

Distance and direction from nearest town or city street address of well if located within city?  
4213 Louisiana Terrace Ottawa Kansas 66067

2 WATER WELL OWNER: J.R. Pennington 566-8807  
 RR#, St. Address, Box #: P.O. Box 55  
 City, State, ZIP Code: Pomona, Ks. 66076  
 Board of Agriculture, Division of Water Resources  
 Application Number:

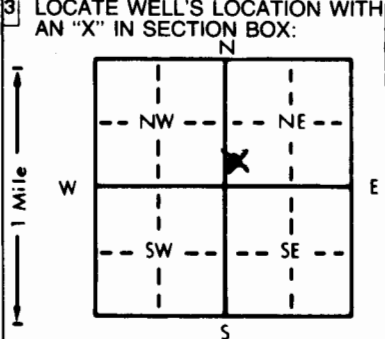

4 DEPTH OF COMPLETED WELL: 125 ft. ELEVATION: ..... ft.  
 Depth(s) Groundwater Encountered 1. 63-100 ft. 2. .... ft. 3. .... ft.  
 WELL'S STATIC WATER LEVEL 63 ft. below land surface measured on mo/day/yr Sept 27 93  
 Pump test data: Well water was ..... ft. after ..... hours pumping ..... gpm  
 Est. Yield 15 gpm; Well water was ..... ft. after ..... hours pumping ..... gpm  
 Bore Hole Diameter: 8 3/4 in. to 20 ft., and 7 7/8 in. to 125 ft.  
 WELL WATER TO BE USED AS:  
 1 Domestic  3 Feedlot  6 Oil field water supply  9 Dewatering  12 Other (Specify below)  
 2 Irrigation  4 Industrial  7 Lawn and garden only  10 Monitoring well  
 Was a chemical/bacteriological sample submitted to Department? Yes.....No.....; If yes, mo/day/yr sample was submitted  
 Water Well Disinfected? Yes  No

5 TYPE OF BLANK CASING USED:  
 1 Steel  3 RMP (SR)  5 Wrought iron  8 Concrete tile   
 2 PVC  4 ABS  6 Asbestos-Cement  9 Other (specify below)   
 7 Fiberglass   
 Blank casing diameter 5 in. to 85 ft., Dia. .... in. to .... ft., Dia. .... in. to .... ft.  
 Casing height above land surface 24 in., weight ..... lbs./ft. Wall thickness or gauge No. 200#  
 TYPE OF SCREEN OR PERFORATION MATERIAL:  
 7 PVC  10 Asbestos-cement  
 1 Steel  3 Stainless steel  5 Fiberglass  8 RMP (SR)  
 2 Brass  4 Galvanized steel  6 Concrete tile  9 ABS  12 None used (open hole)  
 SCREEN OR PERFORATION OPENINGS ARE:  
 1 Continuous slot  3 Mill slot  5 Gauzed wrapped  8 Saw cut  11 None (open hole)  
 2 Louvered shutter  4 Key punched  6 Wire wrapped  9 Drilled holes  
 7 Torch cut  10 Other (specify) .....  
 SCREEN-PERFORATED INTERVALS: From 85 ft. to 125 ft., From ..... ft. to ..... ft.  
 From ..... ft. to ..... ft., From ..... ft. to ..... ft.  
 GRAVEL PACK INTERVALS: From 20 ft. to 125 ft., From ..... ft. to ..... ft.  
 From ..... ft. to ..... ft., From ..... ft. to ..... ft.

6 GROUT MATERIAL: 1 Neat cement  2 Cement grout  3 Bentonite  4 Other .....  
 Grout Intervals: From 0 ft. to 20 ft., From ..... ft. to ..... ft., From ..... ft. to ..... ft.  
 What is the nearest source of possible contamination: NONE AT THE TIME  
 1 Septic tank  4 Lateral lines  7 Pit privy  10 Livestock pens  14 Abandoned water well  
 2 Sewer lines  5 Cess pool  8 Sewage lagoon  11 Fuel storage  15 Oil well/Gas well  
 3 Watertight sewer lines  6 Seepage pit  9 Feedyard  12 Fertilizer storage  16 Other (specify below)  
 13 Insecticide storage  
 Direction from well? How many feet?

FROM	TO	LITHOLOGIC LOG	FROM	TO	PLUGGING INTERVALS
0	2	Soil			
2	10	Sand - Brown			
10	63	Shale			
63	89	Sand - Yellow			
89	100	Sand - grey coarse grained			
100	102	limy sand			
102	106	lime			
106	111	sandy silty shale			
111	125	shale			

7 CONTRACTOR'S OR LANDOWNER'S CERTIFICATION: This water well was (1) constructed (2) reconstructed, or (3) plugged under my jurisdiction and was completed on (mo/day/year) 9-27-93 and this record is true to the best of my knowledge and belief. Kansas Water Well Contractor's License No. 561 This Water Well Record was completed on (mo/day/yr) 9-27-93 under the business name of Evans Energy Development, Inc. by (signature) Seth Q. E.

INSTRUCTIONS: Use typewriter or ball point pen. PLEASE PRESS FIRMLY and PRINT clearly. Please fill in blanks, underline or circle the correct answers. Send top three copies to Kansas Department of Health and Environment, Bureau of Water, Topeka, Kansas 66620-0001. Telephone: 913-296-5545. Send one to WATER WELL OWNER and retain one for your records.