


1 LOCATION OF WATER WELL: County: Franklin Fraction: NE 1/4 SW 1/4 NE 1/4 Section Number: 9 Township Number: T 16 S Range Number: R 19 E

Distance and direction from nearest town or city street address of well if located within city? 3 east 1/2 south 1/2 west Centropolis

2 WATER WELL OWNER: John Clark
 RR#, St. Address, Box #: RR 1
 City, State, ZIP Code: Ottawa, Kan 66067
 Board of Agriculture, Division of Water Resources
 Application Number:

3 LOCATE WELL'S LOCATION WITH AN "X" IN SECTION BOX: NE
 4 DEPTH OF COMPLETED WELL: 115 ft. ELEVATION:
 Depth(s) Groundwater Encountered: 1 48 31 ft. 2. ft. 3. ft.
 WELL'S STATIC WATER LEVEL: 48 31 ft. below land surface measured on mo/day/yr Sept 6, 82

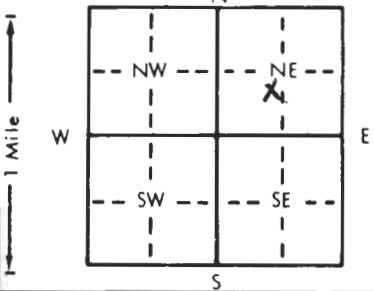

Pump test data: Well water was ft. after hours pumping gpm
 Est. Yield: 4 gpm Well water was ft. after hours pumping gpm
 Bore Hole Diameter: 8 1/4 in. to 22 ft., and 6 1/4 in. to 115 ft.
 WELL WATER TO BE USED AS:
 1 Domestic 3 Feedlot 6 Oil field water supply 9 Dewatering 11 Injection well
 2 Irrigation 4 Industrial 7 Lawn and garden only 10 Observation well
 Was a chemical/bacteriological sample submitted to Department? Yes No; If yes, mo/day/yr sample was submitted
 Water Well Disinfected? Yes No

5 TYPE OF BLANK CASING USED:
 1 Steel 3 RMP (SR) 5 Wrought iron 8 Concrete tile CASING JOINTS: Glued Clamped
 2 PVC 4 ABS 6 Asbestos-Cement 9 Other (specify below) Welded
 Blank casing diameter: 6 1/4 in. to 22 ft., Dia. in. to ft., Dia. in. to ft.
 Casing height above land surface: 18 in., weight Sch 40 lbs./ft. Wall thickness or gauge No. Sch 40
 7 Fiberglass Threaded
 TYPE OF SCREEN OR PERFORATION MATERIAL:
 1 Steel 3 Stainless steel 5 Fiberglass 8 RMP (SR) 10 Asbestos-cement
 2 Brass 4 Galvanized steel 6 Concrete tile 9 ABS 12 None used (open hole)
 11 Other (specify)
 SCREEN OR PERFORATION OPENINGS ARE:
 1 Continuous slot 3 Mill slot 5 Gauzed wrapped 8 Saw cut 11 None (open hole)
 2 Louvered shutter 4 Key punched 6 Wire wrapped 9 Drilled holes
 7 Torch cut 10 Other (specify)

SCREEN-PERFORATED INTERVALS: From ft. to ft., From ft. to ft.
 GRAVEL PACK INTERVALS: From ft. to ft., From ft. to ft.

6 GROUT MATERIAL: 1 Neat cement 2 Cement grout 3 Bentonite 4 Other
 Grout Intervals: From 3 ft. to 22 ft., From ft. to ft., From ft. to ft.
 What is the nearest source of possible contamination:
 1 Septic tank 4 Lateral lines 7 Pit privy 10 Livestock pens 14 Abandoned water well
 2 Sewer lines 5 Cess pool 8 Sewage lagoon 11 Fuel storage 15 Oil well/Gas well
 3 Watertight sewer lines 6 Seepage pit 9 Feedyard 12 Fertilizer storage 16 Other (specify below) Pasture
 13 Insecticide storage
 Direction from well? How many feet?

FROM	TO	LITHOLOGIC LOG	FROM	TO	LITHOLOGIC LOG
0	3	Soil			
3	31	yellow sand			
31	100	Rock			
100	115	gray sand			
		white sand			

7 CONTRACTOR'S OR LANDOWNER'S CERTIFICATION: This water well was (1) constructed, (2) reconstructed, or (3) plugged under my jurisdiction and was completed on (mo/day/year) Sept 6, 82 and this record is true to the best of my knowledge and belief. Kansas Water Well Contractor's License No. 351 This Water Well Record was completed on (mo/day/yr) Sept 6, 82 under the business name of Royce Swank Drilling by (signature) Royce Swank

INSTRUCTIONS: Use typewriter or ball point pen, PLEASE PRESS FIRMLY and PRINT clearly. Please fill in blanks, underline or circle the correct answers. Send top three copies to Kansas Department of Health and Environment, Division of Environment, Environmental Geology Section, Topeka, KS 66620. Send one to WATER WELL OWNER and retain one for your records.