

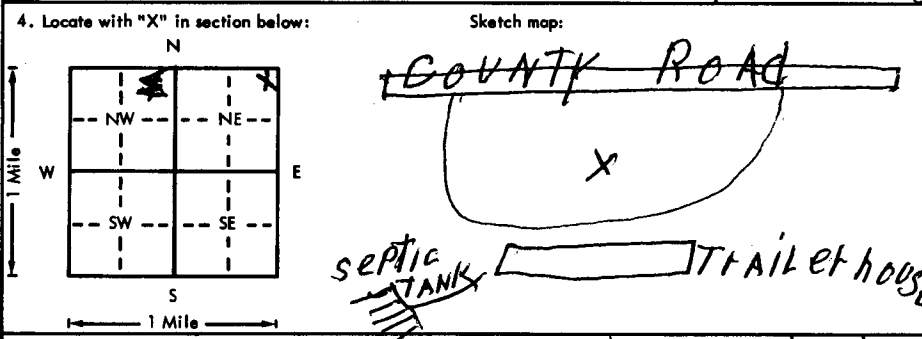
USE TYPEWRITER OR BALL POINT PEN-PRESS FIRMLY, PRINT CLEARLY.

WATER WELL RECORD
KSA 82a-1201-1215

Kansas Department of Health and Environment-Division of Environment (Water well Contractors) Topeka, Kansas 66620

1. Location of well: County Franklin Fraction N.E. 1/4 N.E. 1/4 N.E. 1/4 Section number 11 Township number T 16 S R 19 E/W

2. Distance and direction from nearest town or city: 4 mi - N 1 1/2 Mile West 3. Owner of well: Glenn Jackson
Street address of well location if in city: Ottawa, Kansas R.R. or street: R. 8.4
City, state, zip code: Ottawa, Kansas 66067

4. Locate with "X" in section below: Sketch map: COUNTY ROAD


6. Bore hole dia. 4 1/2 in. Completion date 8-18-76
Well depth 70 ft. 90 ft. 8 1/2 ft.

7. Cable tool Rotary Driven Dug
 Hollow rod Jetted Bored Reverse rotary

8. Use: Domestic Public supply Industry
 Irrigation Air conditioning Stock
 Lawn Oil field water Other

9. Casing: Material PVC Height: Above or below
Threaded Welded Surface 2 1/2 in.
RMP PVC Weight 305 lbs./ft.
Dia. 4 1/2 in. to 70 ft. depth Wall Thickness: inches or
Dia. in. to ft. depth gage No. 255

5. Type and color of material	From	To
Soil	0	5
Clay	5	14
Yellow Sand Rock	14	35
Grey Sand	35	65
Lime	65	67
Grey Shale	67	70

10. Screen: Manufacturer's name None
Type Dia.
Slot/gauze Length
Set between ft. and ft.
 ft. and ft.
Gravel pack? Size range of material

11. Static water level: mo./day/yr.
20 ft. below land surface Date 8-18-76

12. Pumping level below land surfaces:
 ft. after hrs. pumping g.p.m.
 ft. after hrs. pumping g.p.m.
Estimated maximum yield 10 g.p.m.

13. Water sample submitted: mo./day/yr.
Yes No Date

14. Well head completion:
 Pitless adapter 24 inches above grade

15. Well grouted?
With: Neat cement Bentonite Concrete
Depth: From 0 ft. to 20 ft.

16. Nearest source of possible contamination:
ft. 100 Direction South Type Septic
Well disinfected upon completion? Yes No

17. Pump: Not installed
Manufacturer's name
Model number HP Volts
Length of drop pipe ft. capacity g.p.m.
Type:
 Submersible Turbine
 Jet Reciprocating
 Centrifugal Other

18. Elevation:
Topography: Hill Slope Upland Valley

19. Remarks: Customer is going put his own pump in and pour the cement slab. Cement around casing HAS BEEN POUR.

20. Water well contractor's certification:
This well was drilled under my jurisdiction and this report is true to the best of my knowledge and belief.
Edgar Swank Drilling 121A
Business name H.R. L. Ottawa, Kansas License No.
Address
Signed Edgar Swank Date 4-5-76
Authorized representative

Forward the white, blue and pink copies to the Department of Health and Environment

Form WWC-5

T 16 S R 19 E/W Sec 4 - NE 1/4 NE 1/4