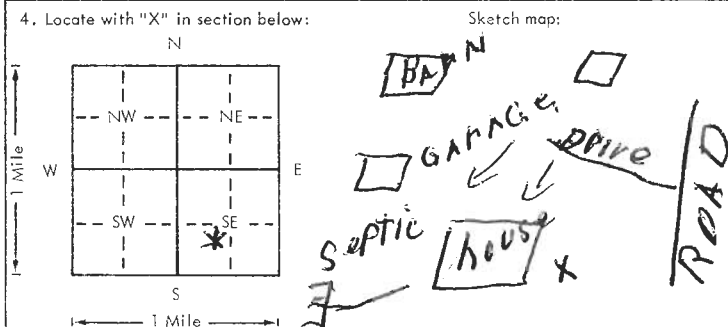


USE TYPEWRITER OR BALL POINT PEN-PRESS FIRMLY, PRINT CLEARLY.

WATER WELL RECORD
KSA 82a-1201-1215

Kansas Department of Health and Environment-Division of Environment
(Water well Contractors)
Topeka, Kansas 66620

1. Location of well: County <u>Franklin</u> Fraction <u>NE 1/4 SW 1/4 SE 1/4</u> Section number <u>5</u> Township number <u>T 16 S R 19</u> Range number <u>19</u>																
2. Distance and direction from nearest town or city: <u>4 MI NORTH 3 1/2 West</u> Street address of well location if in city: <u>Ottawa Kans</u>																
3. Owner of well: <u>EUGENE FOSTER</u> R.R. or street: <u>R4</u> City, state, zip code: <u>Ottawa Kans. 66067</u>																
4. Locate with "X" in section below: Sketch map: 																
5. Type and color of material																
<table border="1"> <thead> <tr> <th></th> <th>From</th> <th>To</th> </tr> </thead> <tbody> <tr> <td>SOIL & CLAY</td> <td>0</td> <td>22</td> </tr> <tr> <td>YELLOW SAND</td> <td>22</td> <td>47</td> </tr> <tr> <td>GRAY SAND STONE</td> <td>47</td> <td>60</td> </tr> <tr> <td>" S. HALD</td> <td>60</td> <td>68</td> </tr> </tbody> </table>			From	To	SOIL & CLAY	0	22	YELLOW SAND	22	47	GRAY SAND STONE	47	60	" S. HALD	60	68
	From	To														
SOIL & CLAY	0	22														
YELLOW SAND	22	47														
GRAY SAND STONE	47	60														
" S. HALD	60	68														
6. Bore hole dia. <u>6 1/4</u> in. Completion date <u>9-19-78</u> Well depth <u>68</u> ft. <u>9" to 2 1/2"</u>																
7. <input checked="" type="checkbox"/> Cable tool <input type="checkbox"/> Rotary <input type="checkbox"/> Driven <input type="checkbox"/> Dug <input type="checkbox"/> Hollow rod <input type="checkbox"/> Jetted <input type="checkbox"/> Bored <input type="checkbox"/> Reverse rotary																
8. Use: <input checked="" type="checkbox"/> Domestic <input type="checkbox"/> Public supply <input type="checkbox"/> Industry <input type="checkbox"/> Irrigation <input type="checkbox"/> Air conditioning <input type="checkbox"/> Stock <input type="checkbox"/> Lawn <input type="checkbox"/> Oil field water <input type="checkbox"/> Other																
9. Casing: Material _____ Height: Above or Below _____ Threaded _____ Welded _____ Surface <u>18</u> in. RMP _____ PVC <input checked="" type="checkbox"/> Weight <u>sch 40</u> lbs./ft. Dia. <u>6 1/4</u> in. to <u>24</u> ft. depth Wall Thickness: inches or _____ Dia. _____ in. to _____ ft. depth gage No. <u>sch 40</u>																
10. Screen: Manufacturer's name _____ Type <u>NONE</u> Dia. _____ Slot/gauze _____ Length _____ Set between _____ ft. and _____ ft. _____ ft. and _____ ft. Gravel pack? _____ Size range of material _____																
11. Static water level: _____ mo./day/yr. <u>28</u> ft. below land surface Date <u>9-19-78</u>																
12. Pumping level below land surfaces: _____ ft. after _____ hrs. pumping _____ g.p.m. _____ ft. after _____ hrs. pumping _____ g.p.m. Estimated maximum yield <u>10</u> g.p.m.																
13. Water sample submitted: _____ mo./day/yr. Yes <input type="checkbox"/> No <input checked="" type="checkbox"/> Date _____																
14. Well head completion: <u>Pump House</u> Pitless adapter _____ Inches above grade																
15. Well grouted? <input checked="" type="checkbox"/> With: <input checked="" type="checkbox"/> Neat cement <input type="checkbox"/> Bentonite <input type="checkbox"/> Concrete Depth: From <u>0</u> ft. to <u>22</u> ft.																
16. Nearest source of possible contamination: ft. <u>65</u> Direction <u>SW</u> Type <u>SEPTIC</u> Well disinfected upon completion? <input checked="" type="checkbox"/> Yes <input type="checkbox"/> No																
17. Pump: <input checked="" type="checkbox"/> Not installed Manufacturer's name _____ Model number _____ HP _____ Volts _____ Length of drop pipe _____ ft. capacity _____ g.p.m. Type: _____ Submersible _____ Turbine _____ Jet _____ Reciprocating _____ Centrifugal _____ Other _____																
(Use a second sheet if needed)																
18. Elevation: Topography: _____ Hill _____ Slope _____ <input checked="" type="checkbox"/> Upland _____ Valley	19. Remarks: <u>This well was drilled in sept but was not comp. till 10-30-78</u>															
20. Water well contractor's certification: This well was drilled under my jurisdiction and this report is true to the best of my knowledge and belief. <u>EDGAR SWANK DRILL 129</u> Business name _____ License No. _____ Address <u>R4 OTTAWA KANS 66067</u> Signed <u>Edgar Swank</u> Date <u>12-10-78</u> Authorized representative																

T 16 R 19 W E S NE S USE