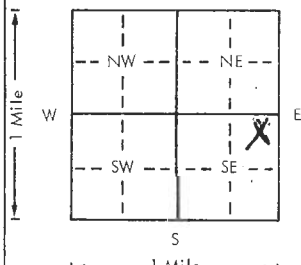


USE TYPEWRITER OR BALL POINT PEN-PRESS FIRMLY, PRINT CLEARLY.

975

WATER WELL RECORD
KSA 82a-1201-1215

Kansas Department of Health and Environment-Division of Environment (Water well Contractors) Topeka, Kansas 66620

1. Location of well:	County Franklin	Fraction NE 1/4 NE 1/4 SE 1/4	Section number 5	Township number T 16 S R 19 E/W	Range number															
2. Distance and direction from nearest town or city: 25 SE 1/4		3. Owner of well: David Brown		R.R. or street: RR1																
Street address of well location if in city: OTTAWA		City, state, zip code: Ottawa, Kan. 66067		6. Bore hole dia. 6 1/2 in. Completion date: 6/2/78 Well depth 100 ft.																
4. Locate with "X" in section below: N W E S 1 Mile Sketch map: 			7. <input checked="" type="checkbox"/> Cable tool <input type="checkbox"/> Rotary <input type="checkbox"/> Driven <input type="checkbox"/> Dug <input type="checkbox"/> Hollow rod <input type="checkbox"/> Jetted <input type="checkbox"/> Bored <input type="checkbox"/> Reverse rotary																	
5. Type and color of material			8. Use: <input checked="" type="checkbox"/> Domestic <input type="checkbox"/> Public supply <input type="checkbox"/> Industry <input type="checkbox"/> Irrigation <input type="checkbox"/> Air conditioning <input type="checkbox"/> Stock <input type="checkbox"/> Lawn <input type="checkbox"/> Oil field water <input type="checkbox"/> Other																	
<table border="1" style="width:100%; border-collapse: collapse;"> <thead> <tr> <th style="width:60%;"></th> <th style="width:10%;">From</th> <th style="width:10%;">To</th> </tr> </thead> <tbody> <tr> <td>soil soil</td> <td>0</td> <td>6</td> </tr> <tr> <td>yellow sand rock</td> <td>6</td> <td>63</td> </tr> <tr> <td>grey sanded shald</td> <td>63</td> <td>96</td> </tr> <tr> <td>shald</td> <td>96</td> <td>100</td> </tr> </tbody> </table>				From	To	soil soil	0	6	yellow sand rock	6	63	grey sanded shald	63	96	shald	96	100	9. Casing: Material _____ Height: Above or Below Threaded _____ Welded _____ Surface 18 in. RMP _____ PVC <input checked="" type="checkbox"/> Weight sch 40 lbs./ft. Dia. 6 1/2 in. to 20 ft. depth; Wall Thickness: inches or Dia. _____ in. to _____ ft. depth; gage No. sch 40		
				From	To															
soil soil	0	6																		
yellow sand rock	6	63																		
grey sanded shald	63	96																		
shald	96	100																		
			10. Screen: Manufacturer's name _____ none Type _____ Dia. _____ Slot/gauze _____ Length _____ Set between _____ ft. and _____ ft. _____ ft. and _____ ft. Gravel pack? no Size range of material _____																	
			11. Static water level: _____ ft. below land surface Date 6/2/78																	
			12. Pumping level below land surfaces: _____ ft. after _____ hrs. pumping _____ g.p.m. _____ ft. after _____ hrs. pumping _____ g.p.m. Estimated maximum yield 5 _____ g.p.m.																	
			13. Water sample submitted: _____ mo./day/yr. Yes <input checked="" type="checkbox"/> No <input type="checkbox"/> Date _____																	
			14. Well head completion: <input type="checkbox"/> Pitless adapter _____ Inches above grade																	
			15. Well grouted? _____ With: <input checked="" type="checkbox"/> Neat cement <input type="checkbox"/> Bentonite <input type="checkbox"/> Concrete Depth: From 3 ft. to 20 ft.																	
			16. Nearest source of possible contamination: none ft. _____ Direction _____ Type _____ Well disinfected upon completion? _____ Yes _____ No																	
			17. Pump: <input checked="" type="checkbox"/> Not installed Manufacturer's name _____ Model number _____ HP _____ Volts _____ Length of drop pipe _____ ft. capacity _____ g.p.m. Type: <input type="checkbox"/> Submersible <input type="checkbox"/> Turbine <input type="checkbox"/> Jet <input type="checkbox"/> Reciprocating <input type="checkbox"/> Centrifugal <input type="checkbox"/> Other																	
(Use a second sheet if needed)																				
18. Elevation: Topography: <input checked="" type="checkbox"/> Hill <input type="checkbox"/> Slope <input type="checkbox"/> Upland <input type="checkbox"/> Valley		19. Remarks: In the middle of a pasture no contamination as yet. NO Building		20. Water well contractor's certification: This well was drilled under my jurisdiction and this report is true to the best of my knowledge and belief. Royce Swank Drilling 371 Business name License No. Address RR1 Ottawa Kan., 66067 Signed Royce Swank Date 10-14 Authorized representative																

T 16 S R 19 E/W NE 1/4 SE 1/4