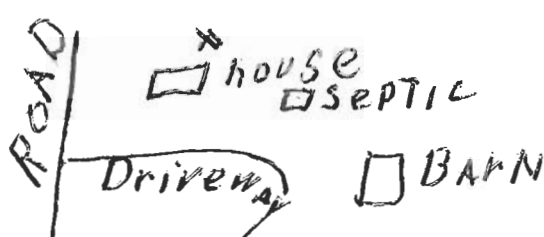


USE TYPEWRITER OR BALL POINT PEN-PRESS FIRMLY, PRINT CLEARLY.

WATER WELL RECORD
KSA 82a-1201-1215

Kansas Department of Health and Environment-Division of Environment (Water well Contractors) Topeka, Kansas 66620

1. Location of well:	County Franklin	Fraction S. E. 1/4 N. E. 1/4 N. E. 1/4	Section number 6	Township number T 16 S R 19	Range number E/W
2. Distance and direction from nearest town or city: 1 1/2 mile South, 1/2 mile East, 1/2 mile South CENTROPOLIS			3. Owner of well: IVA JANE Houston R.R. or street: R.R. #4 City, state, zip code: Ottawa, Kansas, 66067		
4. Locate with "X" in section below: N 1 Mile W E S 1 Mile			Sketch map: 		
5. Type and color of material			From	To	6. Bore hole dia. 6 1/2 in. Completion date 8-17-77 Well depth 121 ft. 9" to 21"
Soil & Clay			0	9	7. <input checked="" type="checkbox"/> Cable tool <input type="checkbox"/> Rotary <input type="checkbox"/> Driven <input type="checkbox"/> Dug <input type="checkbox"/> Hollow rod <input type="checkbox"/> Jetted <input type="checkbox"/> Bored <input type="checkbox"/> Reverse rotary
Mud			9	25	8. Use: <input checked="" type="checkbox"/> Domestic <input type="checkbox"/> Public supply <input type="checkbox"/> Industry <input type="checkbox"/> Irrigation <input type="checkbox"/> Air conditioning <input type="checkbox"/> Stock <input type="checkbox"/> Lawn <input type="checkbox"/> Oil field water <input type="checkbox"/> Other
Shale			25	125	<input checked="" type="checkbox"/> Casing: Material _____ Height: Above or below Threaded _____ Welded _____ Surface 18 in. RMP _____ PVC <input checked="" type="checkbox"/> Weight _____ lbs./ft. Dia. 6 1/2 in. to 20 ft. depth Wall Thickness: inches or Dia. _____ in. to _____ ft. depth gage No. 2 1/2
					10. Screen: Manufacturer's name Crown Line Type PVC Dia. 5" Slot/gauze 3/8 Length 20 Set between 105 ft. and 125 ft. ft. and _____ ft.
					11. Static water level: _____ mo./day/yr. 60 ft. below land surface Date 8-17-77
					12. Pumping level below land surfaces: _____ ft. after _____ hrs. pumping _____ g.p.m. _____ ft. after _____ hrs. pumping _____ g.p.m. Estimated maximum yield 1 g.p.m.
					13. Water sample submitted: _____ mo./day/yr. Yes <input checked="" type="checkbox"/> No <input type="checkbox"/> Date _____
					14. Well head completion: <input checked="" type="checkbox"/> Pitless adapter 18 inches above grade
					15. Well grouted? <input checked="" type="checkbox"/> With <input checked="" type="checkbox"/> Neat cement <input type="checkbox"/> Bentonite <input type="checkbox"/> Concrete Depth: From 3 ft. to 15 ft.
					16. Nearest source of possible contamination: ft. 100 Direction E Type septic Well disinfected upon completion? _____ Yes _____ No
					17. Pump: Manufacturer's name Red Jacket Not installed Model number SONI-9BC HP 1/2 Volt 220 Length of drop pipe 115 ft. capacity 5 g.p.m. Type: <input checked="" type="checkbox"/> Submersible _____ Turbine _____ Jet _____ Reciprocating _____ Centrifugal _____ Other
18. Elevation:			19. Remarks: Cement Platform will be finish when ground settles down		
Topography: <input type="checkbox"/> Hill <input type="checkbox"/> Slope <input checked="" type="checkbox"/> Upland <input type="checkbox"/> Valley			20. Water well contractor's certification: This well was drilled under my jurisdiction and this report is true to the best of my knowledge and belief. Edgar Swank Drilling 124A Business name License No. Address R.R. #4, Ottawa, Kansas Signed Edgar Swank Date 10-4-77 Authorized representative		

T
R
W
Sec
1/4
1/4
1/4
1/4
BENEWE