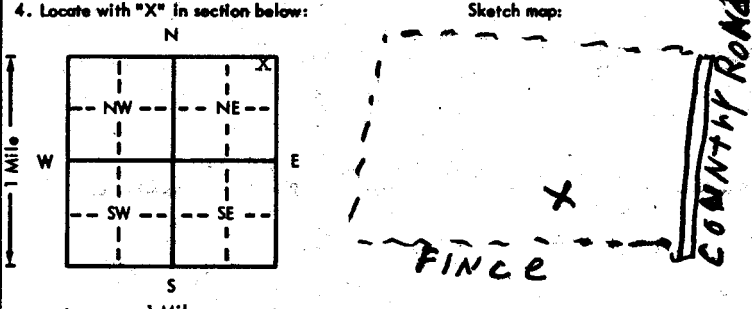


USE TYPEWRITER OR BALL
POINT PEN-PRESS FIRMLY,
PRINT CLEARLY.

WATER WELL RECORD
KSA 82a-1201-1215

Kansas Department of Health and
Environment-Division of Environment
(Water well Contractors)
Topeka, Kansas 66620

1. Location of well:		County <u>Franklin</u>	Fraction <u>N. E. 1/4 N. E. 1/4 N. E. 1/4</u>	Section number <u>16</u>	Township number <u>T 16</u>	Range number <u>S R 19</u>	E/W <u>E/W</u>
2. Distance and direction from nearest town or city: <u>2N. 2W.</u> Street address of well location if in city: <u>Ottawa, Kansas</u>				3. Owner of well: <u>Mike Cornwell</u> R.R. or street: <u>R.R. 4</u> City, state, zip code: <u>Ottawa, Kansas</u>			
4. Locate with "X" in section below: 				6. Bore hole dia. <u>6</u> in. Completion date <u>9-23-76</u> Well depth <u>140</u> ft. <u>101</u> ft.			
5. Type and color of material				7. ☒ Cable tool ☐ Rotary ☐ Driven ☐ Dug ☐ Hollow rod ☐ Jetted ☐ Bored ☐ Reverse rotary			
				8. Use: ☒ Domestic ☐ Public supply ☐ Industry ☐ Irrigation ☐ Air conditioning ☐ Stock ☐ Lawn ☐ Oil field water ☐ Other			
				9. Casing: Material <u>styrene</u> Height: Above ground <u>2</u> ft. Threaded ☐ Welded ☐ Surface <u>2</u> in. RMP ☐ PVC ☒ Weight <u>10</u> lbs./ft. Dia. <u>5</u> in. to <u>140</u> ft. depth Wall Thickness: inches or Dia. <u>5</u> in. to <u>140</u> ft. depth Log No. <u>320</u>			
				10. Screen: Manufacturer's name <u>X</u> Type <u>5</u> Dia. <u>5</u> Slot/gauze <u>1/16</u> Length <u>20</u> Set between <u>120</u> ft. and <u>140</u> ft. ft. and <u>140</u> ft. Gravel pack? <u>no</u> Size range of material <u> </u>			
				11. Static water level: <u>110</u> ft. below land surface Date <u>9-18-76</u> 12. Pumping level below land surfaces: <u> </u> ft. after <u> </u> hrs. pumping <u> </u> g.p.m. <u> </u> ft. after <u> </u> hrs. pumping <u> </u> g.p.m. Estimated maximum yield <u>10</u> g.p.m.			
13. Water sample submitted: <u> </u> mo./day/yr. ☐ Yes ☒ No Date <u> </u>				14. Well head completion: <u>Pump House</u> ☐ Pitless adapter <u> </u> inches above grade			
15. Well grouted? ☒ With: ☒ Neat cement ☐ Bentonite ☐ Concrete Depth: From <u>0</u> ft. to <u>15</u> ft.				16. Nearest source of possible contamination: <u>None</u> Direction <u>None</u> Type <u> </u> Well disinfected upon completion? ☒ Yes ☐ No			
17. Pump: ☒ Not installed Manufacturer's name <u> </u> Model number <u> </u> HP <u> </u> Volts <u> </u> Length of drop pipe <u> </u> ft. capacity <u> </u> g.p.m. Type: ☐ Submersible ☐ Turbine ☐ Jet ☐ Reciprocating ☐ Centrifugal ☐ Other				18. Elevation: Topography: ☐ Hill ☐ Slope ☒ Upland ☐ Valley			
19. Remarks: <u>Customer</u> <u>Customer will finish floor of pump house</u> <u>when he finish his house. This well is in the</u> <u>pasture and there is no contamination at this</u> <u>time.</u>				20. Water well contractor's certification: ☒ This well was drilled under my jurisdiction and this report is true to the best of my knowledge and belief. <u>Edgar Swank Drilling</u> <u>124</u> Business name License No. Address <u>R.R. 4 Ottawa, Kan.</u> Signed <u> </u> Date <u>9-31</u> Authorized representative			

Forward the white, blue and pink copies to the Department of Health and Environment

Form WWC-5