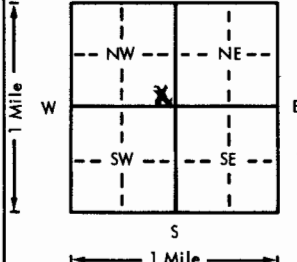
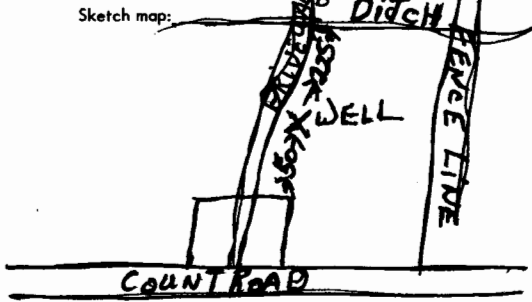


USE TYPEWRITER OR BALL  
POINT PEN-PRESS FIRMLY,  
PRINT CLEARLY.

WATER WELL RECORD  
KSA 82a-1201-1215

Kansas Department of Health and  
Environment-Division of Environment  
(Water well Contractors)  
Topeka, Kansas 66620

1. Location of well:		County <b>FRANKLIN</b>	Eraction <b>SW SE 1/4 SE 1/4 NW 1/4</b>	Section number <b>24</b>	Township number <b>T 16 S R 19 E/W</b>	Range number
2. Distance and direction from nearest town or city:		<b>1 mi NORTH 1/2 E OTTAWA, KANSAS</b>		3. Owner of well: <b>FRED HEATHMAN</b> R.R. or street: <b>R.R.</b> City, state, zip code: <b>OTTAWA, KANSAS 66067</b>		
4. Locate with "X" in section below:		Sketch map:		6. Bore hole dia. <b>6 1/2</b> in. Completion date <b>7/19/76</b> Well depth <b>165</b> ft.		
				7. <input checked="" type="checkbox"/> Cable tool <input type="checkbox"/> Rotary <input type="checkbox"/> Driven <input type="checkbox"/> Dug <input type="checkbox"/> Hollow rod <input type="checkbox"/> Jetted <input type="checkbox"/> Bored <input type="checkbox"/> Reverse rotary		
5. Type and color of material		From		To		8. Use: <input checked="" type="checkbox"/> Domestic <input type="checkbox"/> Public supply <input type="checkbox"/> Industry <input type="checkbox"/> Irrigation <input type="checkbox"/> Air conditioning <input type="checkbox"/> Stock <input type="checkbox"/> Lawn <input type="checkbox"/> Oil field water <input type="checkbox"/> Other
Soil + Joint CLAY		7		0		9. Casing: Material <input type="checkbox"/> Height: Above or below Threaded <input type="checkbox"/> Welded <input type="checkbox"/> Surface <b>NONE</b> in. RMP <input type="checkbox"/> PVC <input type="checkbox"/> Weight <input type="checkbox"/> lbs./ft. Dia. <input type="checkbox"/> in. to <input type="checkbox"/> ft. depth Wall Thickness: inches or Dia. <input type="checkbox"/> in. to <input type="checkbox"/> ft. depth gage No. <input type="checkbox"/>
YELLOW LIME (SHELLY)		5		7		10. Screen: Manufacturer's name <b>NONE</b> Type <input type="checkbox"/> Dia. <input type="checkbox"/> Slot/gauze <input type="checkbox"/> Length <input type="checkbox"/> Set between <input type="checkbox"/> ft. and <input type="checkbox"/> ft. <input type="checkbox"/> ft. and <input type="checkbox"/> ft. Gravel pack? <input type="checkbox"/> Size range of material <input type="checkbox"/>
WHITE LIME		13		12		11. Static water level: <input type="checkbox"/> mo./day/yr. <input type="checkbox"/> ft. below land surface Date <input type="checkbox"/>
BLACK SHALE		3		25		12. Pumping level below land surfaces: <b>NONE</b> <input type="checkbox"/> ft. after <input type="checkbox"/> hrs. pumping <input type="checkbox"/> g.p.m. <input type="checkbox"/> ft. after <input type="checkbox"/> hrs. pumping <input type="checkbox"/> g.p.m. Estimated maximum yield <input type="checkbox"/> g.p.m.
BLUE LIME		3		28		13. Water sample submitted: <input type="checkbox"/> mo./day/yr. <input type="checkbox"/> Yes <input type="checkbox"/> No Date <b>NONE</b>
WHITE LIME		10		55		14. Well head completion: <b>NONE</b> <input type="checkbox"/> Pitless adapter <input type="checkbox"/> Inches above grade
BLUE SHALE		100		65		15. Well grouted? <input checked="" type="checkbox"/> With: <input type="checkbox"/> Neat cement <input type="checkbox"/> Bentonite <input type="checkbox"/> Concrete Depth: From <b>65</b> ft. to <b>80</b> ft. <b>12 ft</b>
<b>DRY HOLE</b>						16. Nearest source of possible contamination: ft. <input type="checkbox"/> Direction <input type="checkbox"/> Type <input type="checkbox"/> Well disinfected upon completion? <input type="checkbox"/> Yes <input type="checkbox"/> No
<b>PLUGGED &amp; CEMENTED</b>						17. Pump: <input type="checkbox"/> Not installed Manufacturer's name <b>NONE</b> Model number <input type="checkbox"/> HP <input type="checkbox"/> Volts <input type="checkbox"/> Length of drop pipe <input type="checkbox"/> ft. capacity <input type="checkbox"/> g.p.m. Type: <input type="checkbox"/> Submersible <input type="checkbox"/> Turbine <input type="checkbox"/> Jet <input type="checkbox"/> Reciprocating <input type="checkbox"/> Centrifugal <input type="checkbox"/> Other
<b>TRACE OF SALT WATER AROUND 90'</b>						20. Water well contractor's certification: This well was drilled under my jurisdiction and this report is true to the best of my knowledge and belief. <b>SWANK WATER WELL DRILLING 107</b> Business name <b>R.T. PRINCETON, KANSAS</b> License No. <input type="checkbox"/> Address <b>George H Swank</b> Date <b>7/21/76</b> Signed <input type="checkbox"/> Authorized representative
18. Elevation:		19. Remarks:				
Topography: <input type="checkbox"/> Hill <input checked="" type="checkbox"/> Slope <input type="checkbox"/> Upland <input type="checkbox"/> Valley		<b>FILLED HOLE PLUGGED TO 80' PACKED WITH DRILLING TOOLS ISACK CEMENT FILLED TO 70' PACKED AGAIN ISACK CEMENT FILLED TO 12' ISACK CEMENT THEN FILLED TO SURFACE.</b>				