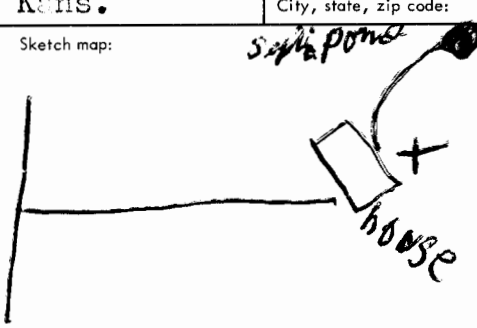


USE TYPEWRITER OR BALL
POINT PEN-PRESS FIRMLY,
PRINT CLEARLY.

WATER WELL RECORD
KSA 82a-1201-1215

Kansas Department of Health and
Environment-Division of Environment
(Water well Contractors)
Topeka, Kansas 66620

1. Location of well:	County Franklin	Fraction N.W. 1/4. W. 1/4	Section number 27	Township number T 16 S R 19 E	Range number 19
2. Distance and direction from nearest town or city: Street address of well location if in city:	1 west, 1/2 north Ottawa, Kans.		3. Owner of well: R.R. or street: City, state, zip code:	Ken XXXX O'Connor R.R. 4 Ottawa, Kansas 66067	
4. Locate with "X" in section below: N W E S 1 Mile	Sketch map: 		6. Bore hole dia. 8 1/2 in. Completion date 6-20-79 Well depth 60 ft. 9" to 44'		
5. Type and color of material			7. <input checked="" type="checkbox"/> Cable tool <input type="checkbox"/> Rotary <input type="checkbox"/> Driven <input type="checkbox"/> Dug <input type="checkbox"/> Hollow rod <input type="checkbox"/> Jetted <input type="checkbox"/> Bored <input type="checkbox"/> Reverse rotary		
			8. Use: <input checked="" type="checkbox"/> Domestic <input type="checkbox"/> Public supply <input type="checkbox"/> Industry <input type="checkbox"/> Irrigation <input type="checkbox"/> Air conditioning <input type="checkbox"/> Stock <input type="checkbox"/> Lawn <input type="checkbox"/> Oil field water <input type="checkbox"/> Other		
			9. Casing: Material <input type="checkbox"/> Height: Above or below ground <input checked="" type="checkbox"/> Threaded <input type="checkbox"/> Welded <input type="checkbox"/> Surface 118 in. RMP 5 60 <input checked="" type="checkbox"/> PVC <input type="checkbox"/> Weight Sch. 40 lbs./ft.		
			Dia. 5 in. to 60 ft. depth Wall Thickness: inches or Dia. 5 in. to 60 ft. depth gage No. 8 Sch. 40		
			10. Screen: Manufacturer's name Jet stream strene Type strene Dia. 5" Slot/gauze 1/8" Length 20 Set between 22 ft. and 42 ft. 1/4" ft. and 1/4" ft. Gravel pack? <input type="checkbox"/> Size range of material 4		
Soil and Clay			From	To	11. Static water level: 20 ft. below land surface Date 6-20-79 mg./day/yr.
Soft xxx sand and gravel			33	42	12. Pumping level below land surfaces: ____ ft. after ____ hrs. pumping ____ g.p.m. ____ ft. after ____ hrs. pumping ____ g.p.m. Estimated maximum yield ____ g.p.m.
Lime			42	44	13. Water sample submitted: ____ mo./day/yr. Yes <input checked="" type="checkbox"/> No <input type="checkbox"/> Date ____
Shale			44	48	14. Well head completion: <input checked="" type="checkbox"/> Pitless adapter 18 inches above grade
Lime			48	60	15. Well grouted? <input checked="" type="checkbox"/> With: <input checked="" type="checkbox"/> Neat cement <input type="checkbox"/> Bentonite <input type="checkbox"/> Concrete Depth: From 36" ft. to 20 ft.
					16. Nearest source of possible contamination: ft. 200 Direction East Type Septic Well disinfected upon completion? <input checked="" type="checkbox"/> Yes <input type="checkbox"/> No
					17. Pump: Not installed Manufacturer's name Red Jacket Model number 5001950 HP 2 Volts 220 Length of drop pipe 50 ft. capacity 10 g.p.m. Type: <input checked="" type="checkbox"/> Submersible pump put in 7-19-79 <input type="checkbox"/> Jet <input type="checkbox"/> Reciprocating <input type="checkbox"/> Centrifugal <input type="checkbox"/> Other
18. Elevation:	19. Remarks: Drilled in pasture. There was no septic system in at the time the well was drilled.		20. Water well contractor's certification: This well was drilled under my jurisdiction and this report is true to the best of my knowledge and belief. Edgar Swank Drilling 124 Business name R.R. 4 Ottawa, Kansas License No. 8-19 Address Edgar Swank Signed Edgar Swank Date 8-19-79 Authorized representative		

Forward the white, blue and pink copies to the Department of Health and Environment

Form WWC-5