


1 LOCATION OF WATER WELL: Fraction SW 1/4 SE 1/4 SE 1/4 Section Number 3 Township Number T 16 S Range Number R 19 E  
 County: Franklin

Distance and direction from nearest town or city street address of well if located within city?

6 miles N, 2 miles W of Ottawa

2 WATER WELL OWNER: Philip J Neary  
 RR#, St. Address, Box # : 2357 Riley Rd.  
 City, State, ZIP Code : Ottawa KS 66067  
 Board of Agriculture, Division of Water Resources  
 Application Number:

3 LOCATE WELL'S LOCATION WITH AN "X" IN SECTION BOX: 4 DEPTH OF COMPLETED WELL 110 ft. ELEVATION: \_\_\_\_\_

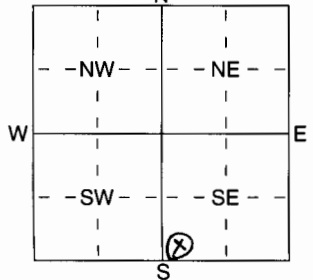

Depth(s) Groundwater Encountered 1 32 ft. 2 60 ft. 3 \_\_\_\_\_ ft.  
 WELL'S STATIC WATER LEVEL 25 ft. below land surface measured on mo/day/yr \_\_\_\_\_  
 Pump test data: Well water was \_\_\_\_\_ ft. after \_\_\_\_\_ hours pumping \_\_\_\_\_ gpm  
 Est. Yield 110 gpm: Well water was \_\_\_\_\_ ft. after \_\_\_\_\_ hours pumping \_\_\_\_\_ gpm  
 WELL WATER TO BE USED AS: 5 Public water supply 8 Air conditioning 11 Injection well  
Domestic 3 Feedlot 6 Oil field water supply 9 Dewatering 12 Other (Specify below)  
 2 Irrigation 4 Industrial 7 Domestic (lawn & garden) 10 Monitoring well \_\_\_\_\_

Was a chemical/bacteriological sample submitted to Department? Yes \_\_\_\_\_ No ; If yes, mo/day/yr sample was submitted  
 Water Well Disinfected? Yes \_\_\_\_\_ No

5 TYPE OF BLANK CASING USED: 5 Wrought iron 8 Concrete tile CASING JOINTS: Glued  Clamped \_\_\_\_\_  
 1 Steel 3 RMP (SR) 6 Asbestos-Cement 9 Other (specify below) Welded \_\_\_\_\_  
2 PVC 4 ABS 7 Fiberglass Threaded \_\_\_\_\_

Blank casing diameter 5 in. to 30 ft., Dia 5 in. to 80 ft., Dia \_\_\_\_\_ in. to 110 ft.  
 Casing height above land surface 18 in., weight 220 PSE lbs./ft. Wall thickness or guage No. SDR 21

TYPE OF SCREEN OR PERFORATION MATERIAL: 7 PVC 10 Asbestos-Cement  
 1 Steel 3 Stainless Steel 5 Fiberglass 8 RMP (SR) 11 Other (Specify) \_\_\_\_\_  
 2 Brass 4 Galvanized Steel 6 Concrete tile 9 ABS 12 None used (open hole)

SCREEN OR PERFORATION OPENINGS ARE: 5 Gauzed wrapped 8 Saw cut 11 None (open hole)  
 1 Continuous slot 3 Mill slot 6 Wire wrapped 9 Drilled holes  
 2 Louvered shutter 4 Key punched 7 Torch cut 10 Other (specify) \_\_\_\_\_ ft.

SCREEN-PERFORATED INTERVALS: From 30 ft. to 40 ft., From 80 ft. to 90 ft.  
 From \_\_\_\_\_ ft. to \_\_\_\_\_ ft., From \_\_\_\_\_ ft. to \_\_\_\_\_ ft.  
 GRAVEL PACK INTERVALS: From 30 ft. to 110 ft., From \_\_\_\_\_ ft. to \_\_\_\_\_ ft.  
 From \_\_\_\_\_ ft. to \_\_\_\_\_ ft., From \_\_\_\_\_ ft. to \_\_\_\_\_ ft.

6 GROUT MATERIAL: 1 Neat cement 2 Cement grout 3 Bentonite 4 Other \_\_\_\_\_  
 Grout Intervals: From 0 ft. to 20 ft., From \_\_\_\_\_ ft. to \_\_\_\_\_ ft., From \_\_\_\_\_ ft. to \_\_\_\_\_ ft.

What is the nearest source of possible contamination:  
1 Septic tank 4 Lateral lines 10 Livestock pens 14 Abandoned water well  
 2 Sewer lines 5 Cess pool 11 Fuel storage 15 Oil well/Gas well  
 3 Watertight sewer lines 6 Seepage pit 8 Sewage lagoon 12 Fertilizer storage 16 Other (specify below)  
 9 Feedyard 13 Insecticide storage

Direction from well? \_\_\_\_\_ How many feet? 150'

FROM	TO	LITHOLOGIC LOG	FROM	TO	PLUGGING INTERVALS
<u>0</u>	<u>10</u>	<u>Silty clay</u>			
<u>10</u>	<u>21</u>	<u>Yellow sandstone</u>			
<u>21</u>	<u>32</u>	<u>Dark yellow sandstone</u>			
<u>32</u>	<u>68</u>	<u>Gray sandstone</u>			
<u>68</u>	<u>76</u>	<u>Limestone</u>			
<u>76</u>	<u>110</u>	<u>Shale</u>			

7 CONTRACTOR'S OR LANDOWNER'S CERTIFICATION: This water well was (1) constructed (2) reconstructed, or (3) plugged under my jurisdiction and was completed on (mo/day/year) 8/29/05 and this record is true to the best of my knowledge and belief. Kansas Water Well Contractor's Licence No 595 This Water Well Record was completed on (mo/day/yr) 10/6/05 under the business name of Jesse Yeakum Well Drilling by (signature) Jesse Yeakum