


MW-3

WATER WELL PLUGGING RECORD Form WWC-5P KSA 82a-1212 ID NO.

1 LOCATION OF WATER WELL: County: Franklin Fraction 1/4 NW 1/4 NW 1/4 SW 1/4 Section Number 31 Township Number T 16 S Range Number 19 E W

Street/Rural Address of Well Location; if unknown, distance & direction from nearest town or intersection: If at owner's address, check here [] Approximately 0.5 miles N of Indiana Road and Highway 68 and 400' E Global Positioning Systems (GPS) information: Latitude: 38.6155 Longitude: 95.35870 Elevation: Horizontal Datum: [X] WGS84, [] NAD83, [] NAD27 Collection Method: [X] GPS unit (Make/Model: etrek 10)

2 WATER WELL OWNER: BNSF Railway RR#, St. Address, Box #: 4515 Kansas Ave. City, State ZIP Code: KC, KS 66106 Est. Accuracy: [] < 3 m, [X] 3-5 m, [] 5-15 m, [] > 15 m

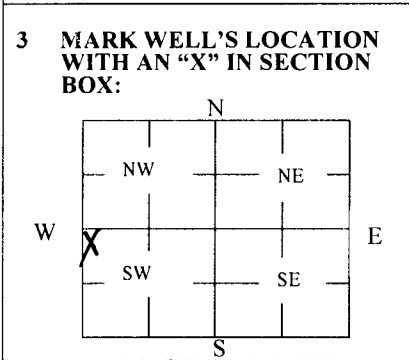

4 DEPTH OF WELL 50 ft. WELL'S STATIC WATER LEVEL _____ ft. WELL WAS USED AS: [] Domestic [] Irrigation [] Feedlot [] Industrial [] Public Water Supply [] Oil Field Water Supply [] Domestic (Lawn & Garden) [] Air Conditioning [X] Dewatering [] Monitoring [] Injection Well [] Other _____ Was a chemical/bacteriological sample submitted to Department? Yes [] No [X]

5 TYPE OF BLANK CASING USED: [X] Steel [] RMP (SR) [] Wrought [] Fiberglass [] Other (Specify below) [X] PVC [] ABS [] Asbestos-Cement [] Concrete Tile Blank casing diameter 2 1/8 in. Was casing pulled? Yes [X] No [] If yes, how much all Casing height above or below land surface 39'0 in.

6 GROUT PLUG MATERIAL: [] Neat cement [X] Cement grout [X] Bentonite [] Other _____ Grout Plug Intervals: From 3 ft. to 10 ft., From 10 ft. to 50 ft., From - ft. to - ft. What is the nearest source of possible contamination: [] Septic tank [] Sewer lines [] Watertight sewer lines [] Lateral lines [] Cess pool [] Seepage pit [] Pit privy [] Sewage lagoon [] Feedyard [] Livestock pens [] Fuel storage [] Fertilizer storage [] Insecticide storage [] Abandoned water well [] Oil well/Gas well [X] Other (specify below) derailment leaving RR car Direction from well? W How many feet? ~125'

Table with 6 columns: FROM, TO, PLUGGING MATERIALS, FROM, TO, PLUGGING MATERIALS. Rows contain: 0-3 Top Soil, 3-10 Bentonite, 10-50 Bentonite Grout.

7 CONTRACTOR'S OR LANDOWNER'S CERTIFICATION: This water well was plugged under my jurisdiction and was completed on (mo/day/year) 4-6-15 and this record is true to the best of my knowledge and belief. Kansas Water Well Contractor's License No. 710. This Water Well Record was completed on (mo/day/year) 4-20-15 under the business name of Below Ground Surface, Inc. by (signature) [Signature]

Send one white copy to Kansas Department of Health & Environment, Geology Section, 1000 SW Jackson Street, Ste. 420, Topeka, KS 66612-1367. Send one copy to WATER WELL OWNER and retain one for your records. Visit us at http://www.kdheks.gov/waterwell/index.html Telephone 785-296-5524.