


1 LOCATION OF WATER WELL: Fraction SW 1/4 NW 1/4 SW 1/4 Section Number 8 Township Number T 16 S Range Number R 2 E
 County: McKasen

Distance and direction from nearest town or city street address of well if located within city?
From K-15 Hwy on k-1 Hwy go 1 mile West of Elma, Kansas & 5/8 mile South

2 WATER WELL OWNER: Johnnie Feeney
 RR#, St. Address, Box #: Rt 2, Box 86 Board of Agriculture, Division of Water Resources
 City, State, ZIP Code: Hape, Kansas 67451 Application Number:

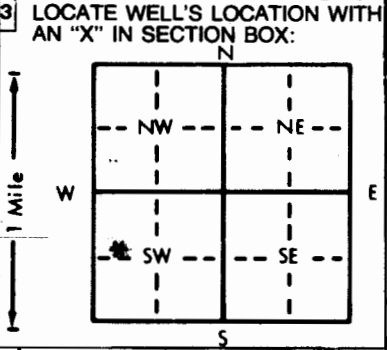

4 DEPTH OF COMPLETED WELL: 45 ft. ELEVATION:
 Depth(s) Groundwater Encountered 1. 13 ft. 2. ft. 3. ft.
 WELL'S STATIC WATER LEVEL: 11 ft. below land surface measured on mo/day/yr 11 / 25 / 88
 Pump test data: Well water was ft. after hours pumping gpm
 Est. Yield 20+ gpm: Well water was ft. after hours pumping gpm
 Bore Hole Diameter: 9 in. to 45 ft., and in. to ft.
 WELL WATER TO BE USED AS:
 5 Public water supply 8 Air conditioning 11 Injection well
 1 Domestic 3 Feedlot 6 Oil field water supply 9 Dewatering 12 Other (Specify below)
 2 Irrigation 4 Industrial 7 Lawn and garden only 10 Monitoring well
 Was a chemical/bacteriological sample submitted to Department? Yes.....No*
 Water Well Disinfected? Yes * No

5 TYPE OF BLANK CASING USED:
 1 Steel 3 RMP (SR) 5 Wrought iron 8 Concrete tile CASING JOINTS: Glued * Clamped
 2 PVC 4 ABS 6 Asbestos-Cement 9 Other (specify below) Welded
 7 Fiberglass Threaded
 Blank casing diameter: 5 in. to 45 ft., Dia in. to ft., Dia in. to ft.
 Casing height above land surface: 24 in., weight 160 lbs./ft. Wall thickness or gauge No. 214
 TYPE OF SCREEN OR PERFORATION MATERIAL:
 1 Steel 3 Stainless steel 5 Fiberglass 7 PVC 10 Asbestos-cement
 2 Brass 4 Galvanized steel 6 Concrete tile 8 RMP (SR) 11 Other (specify)
 9 ABS 12 None used (open hole)
 SCREEN OR PERFORATION OPENINGS ARE:
 1 Continuous slot 3 Mill slot 5 Gauzed wrapped 8 Saw cut 11 None (open hole)
 2 Louvered shutter 4 Key punched 6 Wire wrapped 9 Drilled holes
 7 Torch cut 10 Other (specify)
 SCREEN-PERFORATED INTERVALS: From 13 ft. to 45 ft., From ft. to ft.
 From ft. to ft., From ft. to ft.
 GRAVEL PACK INTERVALS: From 11 ft. to 45 ft., From ft. to ft.
 From ft. to ft., From ft. to ft.

6 GROUT MATERIAL: 1 Neat cement 2 Cement grout 3 Bentonite 4 Other
 Grout Intervals: From 1 ft. to 11 ft., From ft. to ft., From ft. to ft.
 What is the nearest source of possible contamination:
 1 Septic tank 4 Lateral lines 7 Pit privy 10 Livestock pens 14 Abandoned water well
 2 Sewer lines 5 Cess pool 8 Sewage lagoon 11 Fuel storage 15 Oil well/Gas well
 3 Watertight sewer lines 6 Seepage pit 9 Feedyard 12 Fertilizer storage 16 Other (specify below)
 13 Insecticide storage
 Direction from well? NORTH How many feet? approx 100

| FROM | TO | LITHOLOGIC LOG | FROM | TO | PLUGGING INTERVALS |
|------|----|--------------------------|------|----|--------------------|
| 0 | 12 | DARK CLAY | | | |
| 12 | 13 | LITE COLOR SHALE | | | |
| 13 | 16 | GRAY SHALE & GYPSUM HARD | | | |
| 16 | 18 | SOFT DARK SHALE SOFT | | | |
| 18 | 32 | GRAY SHALE | | | |
| 32 | 34 | GYPSUM & SHALE | | | |
| 34 | 35 | GRAY LIME | | | |
| 35 | 40 | GRAY SHALE | | | |
| 40 | 45 | DARK SHALE GYPSUM | | | |

7 CONTRACTOR'S OR LANDOWNER'S CERTIFICATION: This water well was (1) constructed, (2) reconstructed, or (3) plugged under my jurisdiction and was completed on (mo/day/year) 11 / 25 / 88 and this record is true to the best of my knowledge and belief. Kansas Water Well Contractor's License No. 397 This Water Well Record was completed on (mo/day/yr) 1 / 13 / 89 under the business name of CENTRAL KANSAS DRILLING by (signature) Harold D. Martin

802000088-40