


1 LOCATION OF WATER WELL: County: FRANKLIN Fraction: NW 1/4 NW 1/4 NW 1/4 Section Number: 19 Township Number: T 16 S Range Number: R 20 EW

Distance and direction from nearest town or city street address of well if located within city? 1/2 MILE NORTH OF OTTAWA

2 WATER WELL OWNER: RAYMOND RUMFORD
RR#, St. Address, Box #: RT2 Board of Agriculture, Division of Water Resources
City, State, ZIP Code: OTTAWA, KS 66067 Application Number:

3 LOCATE WELL'S LOCATION WITH AN "X" IN SECTION BOX:

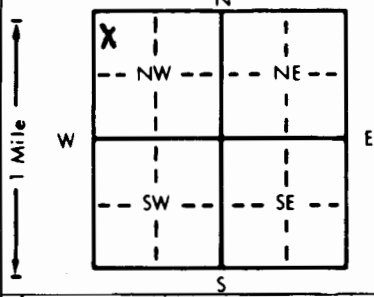

4 DEPTH OF COMPLETED WELL: 62' ft. ELEVATION:

Depth(s) Groundwater Encountered 1. ft. 2. ft. 3. ft.
WELL'S STATIC WATER LEVEL: 25 ft. below land surface measured on mo/day/yr 8-21-92
Pump test data: Well water was ft. after hours pumping gpm
Est. Yield gpm: Well water was ft. after hours pumping gpm
Bore Hole Diameter: in. to ft., and in. to ft.
WELL WATER TO BE USED AS: 5 Public water supply 8 Air conditioning 11 Injection well
1 Domestic 3 Feedlot 6 Oil field water supply 9 Dewatering 12 Other (Specify below)
2 Irrigation 4 Industrial 7 Lawn and garden only 10 Monitoring well
Was a chemical/bacteriological sample submitted to Department? Yes.....No If yes, mo/day/yr sample was submitted
Water Well Disinfected? Yes No

5 TYPE OF BLANK CASING USED: 1 Steel 3 RMP (SR) 5 Wrought iron 8 Concrete tile CASING JOINTS: Glued Clamped
2 Brass 4 ABS 6 Asbestos-Cement 9 Other (specify below) Welded
3 PVC 7 Fiberglass Threaded.....

Blank casing diameter 6" in. to ft., Dia. in. to ft., Dia. in. to ft.
Casing height above land surface 3 FT. Below in., weight lbs./ft. Wall thickness or gauge No.

TYPE OF SCREEN OR PERFORATION MATERIAL: 7 PVC 10 Asbestos-cement
1 Steel 3 Stainless steel 5 Fiberglass 8 RMP (SR) 11 Other (specify) N/A
2 Brass 4 Galvanized steel 6 Concrete tile 9 ABS 12 None used (open hole)

SCREEN OR PERFORATION OPENINGS ARE: 5 Gauzed wrapped 8 Saw cut 11 None (open hole)
1 Continuous slot 3 Mill slot 6 Wire wrapped 9 Drilled holes
2 Louvered shutter 4 Key punched 7 Torch cut 10 Other (specify) N/A

SCREEN-PERFORATED INTERVALS: From N/A ft. to N/A ft., From ft. to ft.
GRAVEL PACK INTERVALS: From — ft. to — ft., From ft. to ft.

6 GROUT MATERIAL: 1 Neat cement 3 Cement grout 3 Bentonite 4 Other
Grout intervals: From 62 ft. to 3 ft., From ft. to ft., From ft. to ft.

What is the nearest source of possible contamination: 10 Livestock pens 14 Abandoned water well
1 Septic tank 4 Lateral lines 7 Pit privy 11 Fuel storage 15 Oil well/Gas well
2 Sewer lines 5 Cess pool 8 Sewage lagoon 12 Fertilizer storage 16 Other (specify below)
3 Watertight sewer lines 6 Seepage pit 9 Feedyard 13 Insecticide storage

Direction from well? OPEN Field How many feet?

FROM	TO	LITHOLOGIC LOG	FROM	TO	PLUGGING INTERVALS
			<u>0</u>	<u>3'</u>	<u>SOFT CEMENT GROUT</u>
			<u>62</u>		

7 CONTRACTOR'S OR LANDOWNER'S CERTIFICATION: This water well was (1) constructed, (2) reconstructed, or (3) plugged under my jurisdiction and was completed on (mo/day/year) 8-21-92 and this record is true to the best of my knowledge and belief. Kansas Water Well Contractor's License No. 536 This Water Well Record was completed on (mo/day/yr) 9-10-92 under the business name of RAYMOND RUMFORD & WELL DRILLING INC. by (signature) Raymond Rumford