


MW-7

1 LOCATION OF WATER WELL: County: Franklin	Fraction ne 1/4 se 1/4 ne 1/4	Section Number 29	Township Number T 16 S	Range Number R 20 E X.W.....
---	----------------------------------	----------------------	---------------------------	---------------------------------

Distance and direction from nearest town or city street address of well if located within city?
Located on the Franklin Co Landfill

2 WATER WELL OWNER: US Geological Survey RR#, St. Address, Box # : 4821 Quail Crest Place City, State, ZIP Code : Lawrence Ks 66049	Board of Agriculture, Division of Water Resources Application Number:
---	--

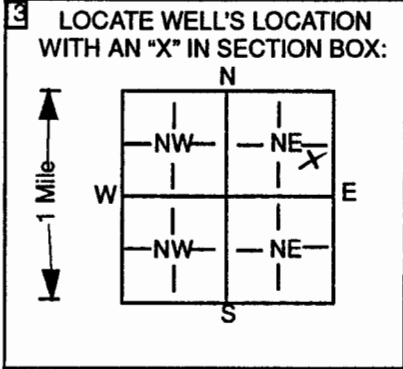

4 DEPTH OF COMPLETED WELL 26.8 ft. ELEVATION: 917.7

Depth(s) Groundwater Encountered 1. dry ft. 2. ft. 3. ft.

WELL'S STATIC WATER LEVEL 6 ft. below land surface measured on mo/day/yr 8/11/92

Pump test data: Well water was... ft. after... hours pumping... gpm

Est. Yield... gpm: Well water was... ft. after... hours pumping... gpm

Bore Hole Diameter 4.5 in. to 26.8 ft. and... in. to... ft.

WELL WATER TO BE USED AS: 5 Public water supply 8 Air conditioning 11 Injection well
1 Domestic 3 Feed lot 6 Oil field water supply 9 Dewatering 10 Observation well MONITORING
2 Irrigation 4 Industrial 7 Lawn and garden

Was a chemical/bacteriological sample submitted to Department? Yes... No X... ; if yes, mo/day/yr sample was submitted

Water well Disinfected? Yes No X

5 TYPE OF BLANK CASING USED:

1 Steel	3 RMP (SR)	5 Wrought iron	8 Concrete tile	CASING JOINTS: Glued..... Clamped.....
2 PVC	4 ABS	6 Asbestos-Cement	9 Other (specify below)	Welded.....
		7 Fiberglass		Threaded X

Blank casing diameter 2 in. to 21.8 ft. Dia. in. to... ft. Dia. in. to... ft.

Casing Height above land surface 42 in., weight... lbs./ft. Wall thickness or gauge No. sch 40

TYPES OF SCREEN OR PERFORATION MATERIAL:

1 Steel	3 Stainless steel	5 Fiberglass	8 RMP (SR)	11 Other (specify).....
2 Brass	4 Galvanized steel	6 Concrete tile	9 ABS	12 None used (open hole)

SCREEN OF PERFORATION OPENINGS ARE:

1 Continuous slot	3 Mill slot	5 Gauzed wrapped	8 Saw cut	11 None (open hole)
2 Louvered shutter	4 Key punched	6 Wire wrapped	9 Drilled holes	
		7 Torch cut	10 Other (specify).....	

SCREENED-PERFORATED INTERVALS: From 26.8 ft. to 21.8 ft., From... ft. to... ft.

GRAVEL PACK INTERVALS: From 26.8 ft. to 14.5 ft., From... ft. to... ft.

6 GROUT MATERIAL:

1 Neat Cement	2 Cement grout	3 Bentonite	Other.....
---------------	----------------	-------------	------------

Grout Intervals: From 14.5 ft. to 2 ft., From... ft. to... ft., From... ft. to... ft.

What is the nearest source of possible contamination:

1 Septic tank	4 Lateral lines	7 Pit privy	10 Asbestos-cement	14 Abandoned water well
2 Sewer lines	5 Cess pool	8 Sewage lagoon	11 Fuel storage	15 Oil well/Gas well
3 Watertight sewer lines	6 Seepage pit	9 Feedyard	12 Fertilizer storage	16 Other (specify below)
			13 None used (open hole)	Landfill

Direction from well? How many feet?

FROM	TO	LITHOLOGIC LOG	FROM	TO	LITHOLOGIC LOG
0	4.0	top soil			
4.0	7.0	tan clay			
7.0	26.5	limestone			
26.5	26.8	black shale			

RECEIVED

AUG 4 1992

DIVISION OF ENVIRONMENT

7 CONTRACTOR'S OR LANDOWNER'S CERTIFICATION: This water well was (1) constructed, (2) reconstructed, or (3) plugged under my jurisdiction and was completed on (mo/day/year) 7/7/92 and this record is true to the best of my knowledge and belief. Kansas Water Well Contractor's License No. This Water Well Record was completed on (mo/day/year) 8/20/92 under the business name of USGS, WRD by (signature) Dick Hargadris

INSTRUCTIONS: Use typewriter or ball point pen. PLEASE PRESS FIRMLY AND PRINT clearly. Please fill in blanks, underline or circle the correct answers. Send top three copies to Kansas Department of Health and Environment, Bureau of Water Protection, Topeka, Kansas 66620-7320, Telephone: 913-862-9360. Send one to WATER WELL OWNER and retain one for your records.

OFFICE USE ONLY

T

R

EW

SEC.

1/4

1/4

1/4