


1 LOCATION OF WATER WELL: County: Franklin Fraction: NW 1/4 SW 1/4 Section Number: 36 Township Number: T 16 S Range Number: R 20 EW

Distance and direction from nearest town or city street address of well if located within city?
5 mi East 1/2 South Ottawa Kans.

2 WATER WELL OWNER: Bill Bond
 RR#, St. Address, Box #: R 4
 City, State, ZIP Code: Ottawa Kans. 66067
 Board of Agriculture, Division of Water Resources
 Application Number:

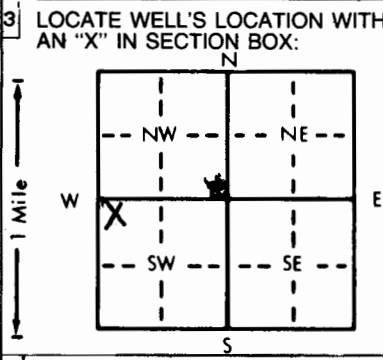

4 DEPTH OF COMPLETED WELL: 100 ft. ELEVATION:
 Depth(s) Groundwater Encountered 1. 18 ft. 2. 28 ft. 3. _____ ft.
 WELL'S STATIC WATER LEVEL unknown NA ft. below land surface measured on mo/day/yr 1-3-90
 Pump test data: Well water was _____ ft. after _____ hours pumping _____ gpm
 Est. Yield Drp gpm: Well water was _____ ft. after _____ hours pumping _____ gpm
 Bore Hole Diameter: 10 in. to 14 ft., and 6 3/8 in. to 100 ft.
 WELL WATER TO BE USED AS:
 Domestic 3 Feedlot 6 Oil field water supply 9 Dewatering 12 Other (Specify below)
 2 Irrigation 4 Industrial 7 Lawn and garden only 10 Observation well
 Was a chemical/bacteriological sample submitted to Department? Yes _____ No
 Water Well Disinfected? Yes _____ No

5 TYPE OF BLANK CASING USED:
 1 Steel 3 RMP (SR) 5 Wrought iron 8 Concrete tile CASING JOINTS: Glued _____ Clamped _____
 2 PVC 4 ABS 6 Asbestos-Cement 9 Other (specify below) Welded _____
 Blank casing diameter 6 1/4 in. to 14 ft., Dia _____ in. to _____ ft., Dia _____ in. to _____ ft.
 Casing height above land surface 18 in., weight sch 40 lbs./ft. Wall thickness or gauge No. sch 40
 TYPE OF SCREEN OR PERFORATION MATERIAL:
 1 Steel 3 Stainless steel 5 Fiberglass 8 RMP (SR) 10 Asbestos-cement
 2 Brass 4 Galvanized steel 6 Concrete tile 9 ABS 11 Other (specify) _____
 None used (open hole)
 SCREEN OR PERFORATION OPENINGS ARE:
 1 Continuous slot 3 Mill slot 5 Gauzed wrapped 8 Saw cut 11 None (open hole)
 2 Louvered shutter 4 Key punched 6 Wire wrapped 9 Drilled holes
 7 Torch cut 10 Other (specify) _____
 SCREEN-PERFORATED INTERVALS: From _____ ft. to _____ ft., From _____ ft. to _____ ft.
 GRAVEL PACK INTERVALS: From _____ ft. to _____ ft., From _____ ft. to _____ ft.
NONE

6 GROUT MATERIAL: 1 Neat cement Cement grout 3 Bentonite 4 Other _____
 Grout Intervals: From 0 ft. to 14 ft., From _____ ft. to _____ ft., From _____ ft. to _____ ft.
 What is the nearest source of possible contamination:
 1 Septic tank 4 Lateral lines 7 Pit privy 10 Livestock pens 14 Abandoned water well
 2 Sewer lines 5 Cess pool 8 Sewage lagoon 11 Fuel storage 15 Oil well/Gas well
 3 Watertight sewer lines 6 Seepage pit 9 Feedyard 12 Fertilizer storage 16 Other (specify below)
 13 Insecticide storage
 Direction from well? SW How many feet? 75

FROM	TO	LITHOLOGIC LOG	FROM	TO	LITHOLOGIC LOG
0	4	Soil & Clay			
4	8	shaly rock			
8	13	lime			
13	22	Black shale			
22	25	lime			
25	28	shale			
28	34	lime			
34	40	shale			
40	51	lime			
51	81	shale			
81	100	lime			

7 CONTRACTOR'S OR LANDOWNER'S CERTIFICATION: This water well was constructed, (2) reconstructed, or (3) plugged under my jurisdiction and was completed on (mo/day/year) 1-3-90 and this record is true to the best of my knowledge and belief. Kansas Water Well Contractor's License No. 486 This Water Well Record was completed on (mo/day/yr) 1-4-90 under the business name of Edgar Swank well Drilling by (signature) Edgar Swank
 INSTRUCTIONS: Use typewriter or ball point pen, PLEASE PRESS FIRMLY and PRINT clearly. Please fill in blanks, underline or circle the correct answers. Send top three copies to Kansas Department of Health and Environment, Division of Environment, Environmental Geology Section, Topeka, KS 66620. Send one to WATER WELL OWNER and retain one for your records.

OFFICE USE ONLY