

Revised

WATER WELL RECORD

Form WWC-5

Division of Water Resources App. No.


Well ID

MW6

Original Record [ ] Correction [X] Change in Well Use [ ]

1 LOCATION OF WATER WELL: County Franklin, Fraction NW 1/4 NW 1/4 NE 1/4 NE 1/4, Section Number 31, Township Number T 16 S, Range Number R 20 E W

2 WELL OWNER: Last Name: Business: S.M. Trading Corporation, Address: 16504 Goddard, City: Overland Park, State: KS, ZIP: 66221, Street or Rural Address where well is located: 2518 E. Logan, Ottawa, KS

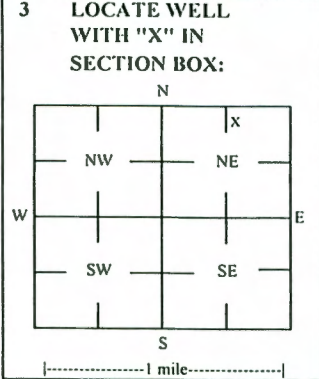

3 LOCATE WELL WITH 'X' IN SECTION BOX: 4 DEPTH OF COMPLETED WELL: 20 ft, Depth(s) Groundwater Encountered: 1) 20 ft, 2) ft, 3) ft, or 4) Dry Well, WELL'S STATIC WATER LEVEL: 3.05 ft, [X] below land surface, measured on (mo-day-yr) 5/19/2021, [ ] above land surface, measured on (mo-day-yr), Pump test data: Well water was ft after hours pumping gpm, Water well was ft after hours pumping gpm, Estimated Yield: gpm, Bore Hole Diameter: 7.25 in to ft, and in to ft

5 Latitude: 38.62237 (decimal degrees), Longitude: 95.23444 (decimal degrees), Horizontal Datum: [X] WGS 84 [ ] NAD 83 [ ] NAD 27, Source for Latitude/Longitude: [ ] GPS (unit make/model: ), (WAAS enabled? [ ] Yes [ ] No), [X] Land Survey [ ] Topographic Map, [ ] Online Mapper

6 Elevation 952.86 ft, [ ] Ground Level [X] TOC, Source [X] Land Survey [ ] GPS [ ] Topographic Map, [ ] Other

7 WELL WATER TO BE USED AS: 1 Domestic: [ ] Household, [ ] Lawn & Garden, [ ] Livestock, 2 Irrigation, 3 Feedlot, 4 Industrial, 5 [ ] Public Water Supply: well ID, 6 [ ] Dewatering: how many wells?, 7 [ ] Aquifer Recharge: well ID, 8 [X] Monitoring: well ID MW6, 9 Environmental Remediation: well ID, [ ] Air Sparge, [ ] Soil Vapor Extractor, [ ] Recovery, [ ] Injection, 10 [ ] Oil Field Water Supply: lease, 11 Test Hole: well ID, [ ] Cased, [ ] Uncased, [ ] Geotechnical, 12 Geothermal: How many bores? a) Closed Loop [ ] Horizontal [ ] Vertical, b) Open Loop [ ] Surface Discharge [ ] Inj. of Water, [ ] Other (specify):

Was a chemical/bacteriological sample submitted to KDHE? [ ] Yes [X] No, If yes, date sample was submitted: Water well disinfected? [ ] Yes [X] No

8 TYPE OF CASING USED: [ ] Steel [X] PVC [ ] Other, CASING JOINTS: [ ] Glued [ ] Clamped [ ] Welded [X] Threaded, Casing diameter 2 in. to 10 ft, Diameter in. to ft, Diameter in. to ft, Casing height above land surface -0.38 in. Weight lbs./ft. Well thickness or gauge No, TYPE OF SCREEN OR PERFORATION MATERIAL: [ ] Steel [ ] Stainless Steel [ ] Fiberglass [X] PVC [ ] Other (Specify), [ ] Brass [ ] Galvanized Steel [ ] Concrete tile [ ] Nonc used (open hole), SCREEN OR PERFORATION OPENINGS ARE: [ ] Continuous Slot [X] Mill Slot [ ] Gauze Wrapped [ ] Torch Cut [ ] Drilled Holes [ ] Other (Specify), [ ] Louvered Shutter [ ] Key Punched [ ] Wire Wrapped [ ] Saw Cut [ ] None (Open Hole), SCREEN-PERFORATED INTERVALS: From 10 ft. to 20 ft., From ft. to ft., From ft. to ft., GRAVEL PACK INTERVALS: From 8 ft. to 20 ft., From ft. to ft., From ft. to ft.,

9 GROUT MATERIAL: [ ] Neat cement [ ] Cement grout [X] Bentonite [X] Other Concrete: 0-0.5', Grout intervals: From 0.5 ft. to 8 ft., From ft. to ft., From ft. to ft.,

Nearest source of possible contamination: [ ] Septic Tank [ ] Lateral Lines [ ] Pit Privy [ ] Livestock Pens [ ] Insecticide Storage, [ ] Sewer Lines [ ] Cess Pool [ ] Swage Lagoon [X] Fuel Storage [ ] Abandoned Water Well, [ ] Watertight Sewer Lines [ ] Seepage Pit [ ] Feedyard [ ] Fertilizer Storage [ ] Oil Well / Gas Well, [ ] Other (Specify): Direction from well? W Distance from well? ~30 ft

Table with 6 columns: FROM, TO, LITHOLOGIC LOG, FROM, TO, LITHO. LOG (cont.) or PLUGGING INTERVALS. Rows: 0-0.7 Concrete, 0.7-1.5 Gravel fill, 1.5-4 Clay, 4-5 Gravely clay, 5-14 Clay, 14-20 Shale

Notes: KDHE ID: Fuel Express #17; U4-030-14948 Target of monitoring well is shallow groundwater, <20' of grout was installed at the direction of KDHE.

11 CONTRACTOR'S OR LANDOWNER'S CERTIFICATION: This water well was [X] constructed, [ ] reconstructed, or [ ] plugged under my jurisdiction and was completed on (mo-day-year) 3/23/21 and this record is true to the best of my knowledge and belief. Kansas Water Well Contractor's License No 757 This Water Well Record was completed on (mo-day-year) under the business name of Larsen & Associates, Inc. Signature

Mail 1 white copy along with a fee of \$5.00 for each constructed well to: Kansas Department of Health and Environment, Bureau of Water, GWTS Section, 1000 SW Jackson St., Suite 420, Topeka, Kansas 66612-1367. Mail one to Water Well Owner and retain one for your records. Telephone 785-296-5524