8

USE TYPEWRITER OR BALL POINT PEN-PRESS FIRMLY, PRINT CLEARLY.

T R EW sec 1/4 1/4 1/4 No.

WATER WELL RECORD
KSA 82a-1201-1215

Lot 30 Crawford

Kansas State Dept. Of Health
(Water Well Contractors)
Forbes-Bldg. 740
Topeka, Kansas 66620

1 Location of well: County	Township name	Fraction	Section number	Town number	Range number
Miami	RICHLAND	~~NE 1/4 NE 1/4~~	26	14S	21-E

Distance and direction from nearest town or city: 4mi South

Street address of well location if in city: 3/4mi E. of Wellsville

3 Owner of well: Elmer Rocker

Address: RRt Wellsville Ks

Locate with "X" in section below:

Sketch map:

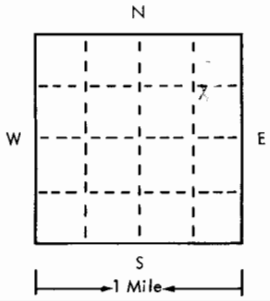

4 Well depth: 119 ft. Date of completion 8-7-75
Well diameter 8 in.

5 ☐ Cable tool ☒ Rotary ☐ Driven ☐ Dug
☐ Hollow rod ☐ Jetted ☐ Bored ☐ Reverse rotary

6 Use: ☒ Domestic ☐ Public supply ☐ Industry
☐ Irrigation ☐ Air conditioning ☐ Commercial
☐ Test well ☐ _____

7 Casing: Material _____ Height: above/below
Threaded ☐ Welded ☒ Surface 29 in.
Diam. 5 in. to 121 5" ft. depth Weight _____ lbs./ft.
_____ in. to _____ ft. depth Drive shoe? ☐ Yes ☐ No

2 Type and color of material	From	To
Clay	0	20
Sandy Shale	20	32
Lime	32	48
Shale	48	65
Sandstone	65	68
Shale	68	119
(use a second sheet if needed)		

8 Screen:
Manufacturer _____
Type PVC Dia. 5"
Slot/gauze 40 Length 3'
Set between 65 ft. and 68 ft.
Fittings:
Gravel pack ☒ Yes ☐ No Size range of material _____

9 Static water level:
37 ft. below land surface Date 8-7-75

10 Pumping level below land surfaces:
_____ ft. after _____ hrs. pumping _____ g.p.m.
_____ ft. after _____ hrs. pumping _____ g.p.m.
Estimated maximum yield 10 g.p.h

11 Water sample submitted:
☐ Yes ☒ No Date _____

12 Well head completion:
☒ Pitless adapter ☐ Inches above grade

13 Well grouted? ☒ Yes ☐ No
☒ Neat cement ☐ Bentonite ☐ _____
Depth: From 3 ft. to 20 ft.

14 Nearest source of possible contamination:
ft. _____ Direction _____ Type _____
Well disinfected upon completion? ☒ Yes ☐ No

15 Pump: ☐ Not installed
Manufacturer's name Jacuzzi
Model number 5J15 HP 1½ Volts 230
Length of drop pipe 110 ft. capacity 6 g.m.p.
Type:
☒ Submersible ☐ Turbine
☐ Jet ☐ Reciprocating
☐ Certrifugal ☐ Other

16 Remarks: elevation
96

Topography:
☐ Hill
☐ Slope
☐ Upland
☐ Valley

17 Water well contractor's certification:
This well was drilled under my jurisdiction and this report is true to the best of my knowledge and belief.
Business name Brewer Drilling License No. 174
Address Baldwin, Ks.
Signed Raphael O. Brewer Date 8/13/75
Authorized representative

Forward the white, blue and pink copies to the Kansas State Dept. Of Health.

Form WWC-5

677-H