

STATE CORPORATION COMMISSION OF KANSAS  
OIL & GAS CONSERVATION DIVISION  
WELL COMPLETION OR RECOMPLETION FORM  
ACO-1 WELL HISTORY  
DESCRIPTION OF WELL AND LEASE

Operator: License # 5115  
Name REESE EXPLORATION INC  
Address 5540 Raytown Rd  
Raytown, MO 64133  
City/State/Zip

Purchaser NA

Operator Contact Person Patty Eichman  
Phone 816/356-1970

Contractor: License # 5661  
Name Kelly Down Drilling Co

Wellsite Geologist None  
Phone

Designate Type of Completion  
 New Well  Re-Entry  Workover

Oil  SWD  Temp Abd  
 Gas  Inj  Delayed Comp.  
 Dry  Other (Core, Water Supply etc.)

If ONWD: old well, info as follows:  
Operator  
Well Name  
Comp. Date Old Total Depth

WELL HISTORY

Drilling Method:  
 Mud Rotary  Air Rotary  Cable  
9-8-87 9-10-87 9-10-87  
Spud Date Date Reached TD Completion Date  
1240 1022  
Total Depth PBD

Amount of Surface Pipe Set and Cemented at 40 feet  
Multiple Stage Cementing Collar Used? Yes No  
If yes, show depth set feet  
If alternate 2 completion, cement circulated  
from surface feet depth to 40 w/ 10 SX.cmt  
Cement Company Name  
Invoice #

API NO. 15-121.26.827  
County Miami  
NE NE NW Sec. 24 Twp. 16 Rge. 21E  
5200 5178 FSL 12782 FCL ICC  
2720 Ft North from Southeast Corner of Section  
Ft West from Southeast Corner of Section  
(Note: Locate well in section plat below)


Lease Name Schendel Well WSW-1

Field Name Paola

Producing Formation Squirrel

Elevation: Ground Unk KB

Section Plat

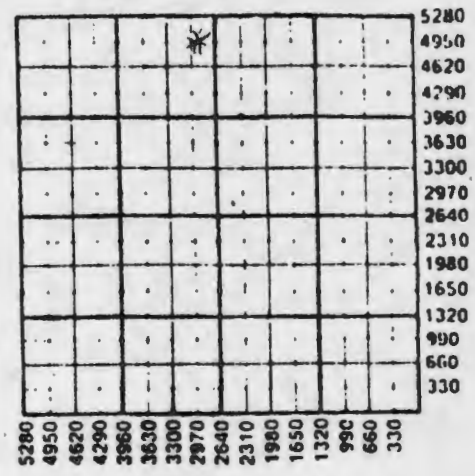

WATER SUPPLY INFORMATION

Disposition of Produced Water: Disposal  
Docket # CR-12813 XX Repressuring  
(C-20,470)

Questions on this portion of the ACO-1 ca  
Water Resources Board (913) 296-3717

Source of Water:  
Division of Water Resources Permit # 38631

Groundwater Ft North from Southeast Corner  
(Well) Ft West from Southeast Corner of  
Sec Twp Rge East West

Surface Water Ft North from Southeast Corner  
(Stream, pond etc) Ft West from Southeast Corner  
Sec Twp Rge East West

Other (explain)  
(purchased from city, R.W.D. #)

INSTRUCTIONS: This form shall be completed in triplicate and filed with the Kansas Corporation Commission, 200 Colorado Derby Building, Wichita, Kansas 67202, within 120 days of the spud date of any well. Rule 82-3-130, 82-3-107 and 82-3-106 apply. Information on side two of this form will be held confidential for a period of 12 months if requested in writing and submitted with the form. See rule 82-3-107 for confidentiality in excess of 12 months. One copy of all wireline logs and drillers time log shall be attached with this form. Submit CP-4 form with all plugged wells. Submit CP-111 form with all temporarily abandoned wells.

Operator Name REESE EXPLORATION, INC. Lease Name Schendel Well # WSW

Sec. 24 Twp. 16 Rge. 21E East West County Miami

WELL LOG

INSTRUCTIONS: Show important tops and base of formations penetrated. Detail all cores. Report all drill tests giving interval tested, time tool open and closed, flowing and shut-in pressures, whether shut-in pressure reached static level, hydrostatic pressures, bottom hole temperature, fluid recovery, and flow rate if gas to surface during test. Attach extra sheet if more space is needed. Attach copy of log.

Drill Stem Tests Taken [ ] Yes [X] No
Samples Sent to Geological Survey [ ] Yes [X] No
Cores Taken [ ] Yes [X] No

Formation Description [X] Log [ ] Sample

Table with 3 columns: Name, Top, Bottom. Rows include Soil & Lime, Clay, Lime & Shale, Miss. Lime, Break, Granular Lime, Break, Lime, Total Depth.

Table for production data with columns: Oil, Gas, Water, Gas-Oil Ratio, Grav. y. Includes handwritten 'N/A' and '300 Bbls CFPB'.

METHOD OF COMPLETION

Production Interval

Disposition of gas: [ ] Vented [ ] Sold [ ] Open Hole [X] Perforation [ ] Other (Specify)
CASING RECORD [X] Now [ ] Used

1092 to 1106

Report all strings set-conductor, surface, intermediate, production, etc.

Table with 8 columns: Purpose of String, Size Hole Drilled, Size Casing Set (in O.D.), Weight Lbs/Ft., Setting Depth, Type of Cement, #Sacks Used, Type and Percent Additives. Rows for Surface and Production.

PERFORATION RECORD

Acid, Fracture, Shot, Cement Squeeze Record (Amount and Kind of Material Used) Depth

Table for perforation record with 3 columns: Shcls Per Foot, Specify Footage of Each Interval Perforated, (Amount and Kind of Material Used) Depth. Includes handwritten '2 Perforate w/ .90 gram shots 1092 to 1106'.

TUBING RECORD Size Set At Packer at Liner Run [ ] Yes [X] No

Date of First Production 10-15-87 Producing Method [ ] Flowing [X] Pumping [ ] Gas Lift [ ] Other (explain)