WATER WELL RECORD Form WWC-5 KSA 82a-1212

LOCATION OF WATER WELL: County: MIAMI	Fraction: 3E ¼ NE ¼ SE ¼	Section Number: 3	Township Number: T 16 (S)	Range Number: R 22 (E) W

Distance and direction from nearest town or city street address of well if located within city?
APPROX. ¼ MILE N. 247ST. + PFLUMM Rd

2 WATER WELL OWNER: KEITH MARTIN
RR#, St. Address, Box # : 6200 W 61ST
City, State, ZIP Code : MISSION, KS 66202

Board of Agriculture, Division of Water Resources
Application Number: NONE

LOCATE WELL'S LOCATION WITH AN "X" IN SECTION BOX:

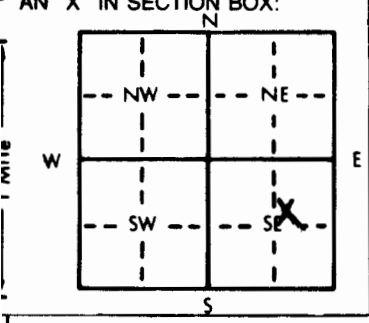

4 DEPTH OF COMPLETED WELL: DRY ft. ELEVATION:
Depth(s) Groundwater Encountered 1. NOT Completed ft. 3. ft.
WELL'S STATIC WATER LEVEL NONE ft. below land surface measured on mo/day/yr
Pump test data: Well water was — ft. after — hours pumping — gpm
Est. Yield NONE gpm: Well water was — ft. after — hours pumping — gpm
Bore Hole Diameter 8" in. to 119 ft., and — in. to — ft.
WELL WATER TO BE USED AS: 5 Public water supply 8 Air conditioning 11 Injection well
1 Domestic 3 Feedlot 6 Oil field water supply 9 Dewatering 12 Other (Specify below) NONE
2 Irrigation 4 Industrial 7 Lawn and garden only 10 Observation well
Was a chemical/bacteriological sample submitted to Department? Yes ..... No —; If yes, mo/day/yr sample was submitted NOT COMPLETED Water Well Disinfected? Yes No —

TYPE OF BLANK CASING USED: NONE 5 Wrought iron 8 Concrete tile CASING JOINTS: Glued Clamped
1 Steel 3 RMP (SR) 6 Asbestos-Cement 9 Other (specify below) Welded
2 PVC 4 ABS 7 Fiberglass Threaded
Blank casing diameter — in. to — ft., Dia in. to ft., Dia in. to ft.
Casing height above land surface NONE in., weight lbs./ft. Wall thickness or gauge No.

TYPE OF SCREEN OR PERFORATION MATERIAL: NONE 7 PVC 10 Asbestos-cement
1 Steel 3 Stainless steel 5 Fiberglass 8 RMP (SR) 11 Other (specify)
2 Brass 4 Galvanized steel 6 Concrete tile 9 ABS 12 None used (open hole)

SCREEN OR PERFORATION OPENINGS ARE: NONE 5 Gauzed wrapped 8 Saw cut 11 None (open hole)
1 Continuous slot 3 Mill slot 6 Wire wrapped 9 Drilled holes
2 Louvered shutter 4 Key punched 7 Torch cut 10 Other (specify)

SCREEN-PERFORATED INTERVALS: From NONE ft. to — ft., From — ft. to — ft.
From — ft. to — ft., From — ft. to — ft.
GRAVEL PACK INTERVALS: From — ft. to — ft., From — ft. to — ft.
From — ft. to — ft., From — ft. to — ft.

GROUT MATERIAL: 1 Neat cement 2 Cement grout 3 Bentonite 4 Other NONE
Grout Intervals: From — ft. to — ft., From — ft. to — ft., From — ft. to — ft.

What is the nearest source of possible contamination: NONE
1 Septic tank 4 Lateral lines 7 Pit privy 10 Livestock pens 14 Abandoned water well
2 Sewer lines 5 Cess pool 8 Sewage lagoon 11 Fuel storage 15 Oil well/Gas well
3 Watertight sewer lines 6 Seepage pit 9 Feedyard 12 Fertilizer storage 16 Other (specify below) DRY HOLE
13 Insecticide storage
Direction from well? DRY HOLE How many feet?

FROM	TO	LITHOLOGIC LOG	FROM	TO	LITHOLOGIC LOG
0	3	SURFACE			
3	17	lime			Filled WITH DIRT +
17	108	Shale			ROCK FROM 119 to
108	119	TIME T.D.			15 FROM 15 to 3 WITH
					CEMENT AND dirt
					to SURFACE

CONTRACTOR'S OR LANDOWNER'S CERTIFICATION: This water well was (1) constructed, (2) reconstructed, or (3) plugged under my jurisdiction and was completed on (mo/day/year) 3/1/82 and this record is true to the best of my knowledge and belief. Kansas Water Well Contractor's License No. 350 This Water Well Record was completed on (mo/day/yr) 2/2/84
under the business name of A G GLOZE DRLG. INC by (signature)

INSTRUCTIONS: Use typewriter or ball point pen, *PLEASE PRESS FIRMLY* and *PRINT* clearly. Please fill in blanks, underline or circle the correct answers. Send top three copies to Kansas Department of Health and Environment, Division of Environment, Environmental Geology Section, Topeka, KS 66620. Send one to WATER WELL OWNER and retain one for your records.