


1 LOCATION OF WATER WELL: County: MIAMI Fraction: NE 1/4 SE 1/4 SE 1/4 Section Number: 35 Township Number: T 16 S Range Number: R 24 EW

Distance and direction from nearest town or city street address of well if located within city?
2 miles East of Louisburg

2 WATER WELL OWNER: Ed Montell
 RR#, St. Address, Box #: Louisburg
 City, State, ZIP Code: _____
 Board of Agriculture, Division of Water Resources
 Application Number: _____

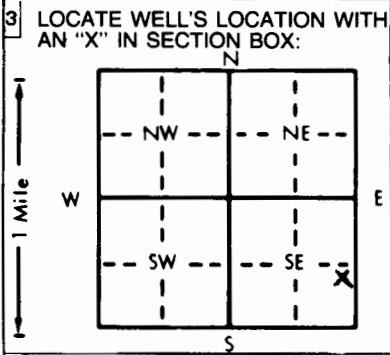

4 DEPTH OF COMPLETED WELL: 50 ft. ELEVATION: _____
 Depth(s) Groundwater Encountered: 1. 15 ft. 2. _____ ft. 3. _____ ft.
 WELL'S STATIC WATER LEVEL: 9' ft. below land surface measured on mo/day/yr 2-23-94
 Pump test data: Well water was _____ ft. after _____ hours pumping _____ gpm
 Est. Yield: 10 gpm: Well water was _____ ft. after _____ hours pumping _____ gpm
 Bore Hole Diameter: 10 in. to 50 ft., and _____ in. to _____ ft.
 WELL WATER TO BE USED AS:
 1 Domestic 3 Feedlot 6 Oil field water supply 9 Dewatering 12 Other (Specify below)
 2 Irrigation 4 Industrial 7 Lawn and garden only 10 Monitoring well
 Was a chemical/bacteriological sample submitted to Department? Yes _____ No X If yes, mo/day/yr sample was submitted _____
 Water Well Disinfected? Yes No

5 TYPE OF BLANK CASING USED:
 1 Steel 3 RMP (SR) 5 Wrought iron 8 Concrete tile CASING JOINTS: Glued Clamped
 2 PVC 4 ABS 6 Asbestos-Cement 9 Other (specify below) Welded
 _____ 7 Fiberglass _____ Threaded
 Blank casing diameter: 5" in. to _____ ft., Dia. _____ in. to _____ ft., Dia. _____ in. to _____ ft.
 Casing height above land surface: 36 in., weight 291 lbs./ft. Wall thickness or gauge No. 265
 TYPE OF SCREEN OR PERFORATION MATERIAL:
 1 Steel 3 Stainless steel 5 Fiberglass 7 PVC 10 Asbestos-cement
 2 Brass 4 Galvanized steel 6 Concrete tile 8 RMP (SR) 11 Other (specify) _____
 _____ 12 None used (open hole)
 SCREEN OR PERFORATION OPENINGS ARE:
 1 Continuous slot 3 Mill slot 5 Gauzed wrapped 8 Saw cut 11 None (open hole)
 2 Louvered shutter 4 Key punched 6 Wire wrapped 9 Drilled holes
 _____ 7 Torch cut 10 Other (specify) _____
 SCREEN-PERFORATED INTERVALS: From 13 ft. to 28 ft., From _____ ft. to _____ ft.
 From 45 ft. to 50 ft., From _____ ft. to _____ ft.
 GRAVEL PACK INTERVALS: From 50 ft. to 12 ft., From _____ ft. to _____ ft.
 From _____ ft. to _____ ft., From _____ ft. to _____ ft.

6 GROUT MATERIAL: 1 Neat cement 2 Cement grout 3 Bentonite 4 Other _____
 Grout Intervals: From 12 ft. to 3 ft., From _____ ft. to _____ ft.
 What is the nearest source of possible contamination:
 1 Septic tank 4 Lateral lines 7 Pit privy 10 Livestock pens 14 Abandoned water well
 2 Sewer lines 5 Cess pool 8 Sewage lagoon 11 Fuel storage 15 Oil well/Gas well
 3 Watertight sewer lines 6 Seepage pit 9 Feedyard 12 Fertilizer storage 16 Other (specify below) _____
 _____ 13 Insecticide storage
 Direction from well? SE How many feet? 200

FROM	TO	LITHOLOGIC LOG	FROM	TO	PLUGGING INTERVALS
0	2	TOP SOIL			
2	10	CLAY - BROWN			
10	15	CHERT GRAVEL 1/4 X 1/2			
15	21	Limestone - Grey			
21	35	shale - Grey			
35	39	Limestone - Grey			
39	50	Shale - Grey			
shallow grout OK by Don Taylor 02-23-94					

7 CONTRACTOR'S OR LANDOWNER'S CERTIFICATION: This water well was (1) constructed, (2) reconstructed, or (3) plugged under my jurisdiction and was completed on (mo/day/year) 2-23-94 and this record is true to the best of my knowledge and belief. Kansas Water Well Contractor's License No. 174 This Water Well Record was completed on (mo/day/yr) 2-23-94 under the business name of Brewer Inc by (signature) John S. Brewer

INSTRUCTIONS: Use typewriter or ball point pen. PLEASE PRESS FIRMLY and PRINT clearly. Please fill in blanks, underline or circle the correct answers. Send top three copies to Kansas Department of Health and Environment, Bureau of Water, Topeka, Kansas 66620-0001. Telephone: 913-296-5545. Send one to WATER WELL OWNER and retain one for your records.