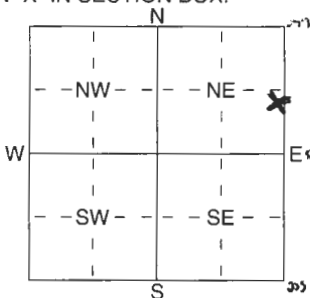


1 LOCATION OF WATER WELL: County: Miami Fraction: NE 1/4 SE 1/4 NE 1/4 Section Number: 8 Township Number: T 16 S Range Number: R 25 E

Distance and direction from nearest town or city street address of well if located within city?  
24934 Rockville Rd. Louisburg, KS.

2 WATER WELL OWNER: Harry Truman RR#, St. Address, Box #: 24540 Rockville Rd. City, State, ZIP Code: Louisburg, KS. 64053  
 Board of Agriculture, Division of Water Resources Application Number: 4-180 bores

3 LOCATE WELL'S LOCATION WITH AN "X" IN SECTION BOX:  
  
 4 DEPTH OF COMPLETED WELL: 180 ft. ELEVATION: ..... ft.  
 Depth(s) Groundwater Encountered: 1 None ft. 2 ..... ft. 3 ..... ft.  
 WELL'S STATIC WATER LEVEL: None ft. below land surface measured on mo/day/yr ..... ft.  
 Pump test data: Well water was ..... ft. after ..... hours pumping ..... gpm  
 Est. Yield: None gpm: Well water was ..... ft. after ..... hours pumping ..... gpm  
 WELL WATER TO BE USED AS:  
 1 Domestic 3 Feedlot 6 Oil field water supply 8 Air conditioning 11 Injection well  
 2 Irrigation 4 Industrial 7 Domestic (lawn & garden) 9 Dewatering 12 Other (Specify below)  
 Was a chemical/bacteriological sample submitted to Department? Yes ..... No X .....; If yes, mo/day/yr sample was submitted  
 Water Well Disinfected? Yes ..... No X .....

5 TYPE OF BLANK CASING USED:  
 1 Steel 3 RMP (SR) 5 Wrought iron 8 Concrete tile CASING JOINTS: Glued ..... Clamped .....  
 2 PVC 4 ABS 6 Asbestos-Cement 9 Other (specify below) Welded: fusion  
 7 Fiberglass H.D. Polyethylene Threaded .....  
 Blank casing diameter: 3.14 in. to 180 ft. Dia ..... in. to ..... ft. Dia ..... in. to ..... ft.  
 Casing height above land surface: 40 in., weight: SOR 11 lbs./ft. Wall thickness or gauge No. ....  
 TYPE OF SCREEN OR PERFORATION MATERIAL: None  
 1 Steel 3 Stainless Steel 5 Fiberglass 7 PVC 10 Asbestos-Cement  
 2 Brass 4 Galvanized Steel 6 Concrete tile 8 RMP (SR) 11 Other (Specify) .....  
 9 ABS 12 None used (open hole)  
 SCREEN OR PERFORATION OPENINGS ARE: None  
 1 Continuous slot 3 Mill slot 5 Gauzed wrapped 8 Saw cut 11 None (open hole)  
 2 Louvered shutter 4 Key punched 6 Wire wrapped 9 Drilled holes  
 7 Torch cut 10 Other (specify) ..... ft.  
 SCREEN-PERFORATED INTERVALS: From ..... ft. to ..... ft., From ..... ft. to ..... ft.  
 GRAVEL PACK INTERVALS: From ..... ft. to ..... ft., From ..... ft. to ..... ft.

6 GROUT MATERIAL: 1 Neat cement 2 Cement grout 3 Bentonite 4 Other .....  
 Grout Intervals: From 180 ft. to 3 ft., From ..... ft. to ..... ft., From ..... ft. to ..... ft.  
 What is the nearest source of possible contamination: None at time of drilling  
 1 Septic tank 4 Lateral lines 7 Pit privy 10 Livestock pens 14 Abandoned water well  
 2 Sewer lines 5 Cess pool 8 Sewage lagoon 11 Fuel storage 15 Oil well/Gas well  
 3 Watertight sewer lines 6 Seepage pit 9 Feedyard 12 Fertilizer storage 16 Other (specify below)  
 13 Insecticide storage .....  
 Direction from well? How many feet?

FROM	TO	LITHOLOGIC LOG	FROM	TO	PLUGGING INTERVALS
0	8	Soil & Ulag			
8	13	Limestone			
13	26	Shale			
26	97	Limestone	180	3	High Solids bentonite
97	152	Shale			
152	162	Limestone			
162	180	Shale			4-180' bores Plugged

RECEIVED  
 NOV 15 2004

BUREAU OF WATER

7 CONTRACTOR'S OR LANDOWNER'S CERTIFICATION: This water well was (1) constructed, (2) reconstructed, or (3) plugged under my jurisdiction and was completed on (mo/day/year) Nov 6, 2004 and this record is true to the best of my knowledge and belief. Kansas Water Well Contractor's Licence No. 56.1 This Water Well Record was completed on (mo/day/yr) Nov 7, 2004 under the business name of Evans Energy Dev Inc. by (signature) [Signature]