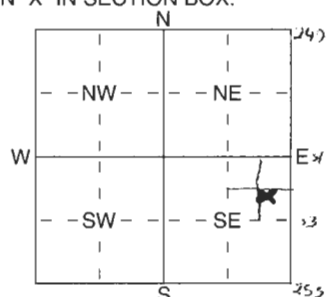


1 LOCATION OF WATER WELL: Fraction SE 1/4 NE 1/4 SE 1/4 Section Number 8 Township Number T 16 S Range Number R 25 E
 County: Miami

Distance and direction from nearest town or city street address of well if located within city?
25234 Rockville Rd Leusberg, Ks.

2 WATER WELL OWNER: Roy Seefeldt : 4-180' bores
 RR#, St. Address, Box # : 708 Autumn Circle
 City, State, ZIP Code : Leusberg KS 66053 Board of Agriculture, Division of Water Resources
 Application Number:

3 LOCATE WELL'S LOCATION WITH AN "X" IN SECTION BOX:  4 DEPTH OF COMPLETED WELLS: 180 ft. ELEVATION: ft.
 Depth(s) Groundwater Encountered 1 NONE ft. 2 ft. 3 ft.
 WELL'S STATIC WATER LEVEL NONE ft. below land surface measured on mo/day/yr
 Pump test data: Well water was ft. after hours pumping gpm
 Est. Yield NONE gpm: Well water was ft. after hours pumping gpm
 WELL WATER TO BE USED AS: 5 Public water supply 8 Air conditioning 11 Injection well
 1 Domestic 3 Feedlot 6 Oil field water supply 9 Dewatering 12 Other (Specify below)
 2 Irrigation 4 Industrial 7 Domestic (lawn & garden) 10 Monitoring well
 Was a chemical/bacteriological sample submitted to Department? Yes No ; If yes, mo/day/yr sample was submitted
 Water Well Disinfected? Yes No

5 TYPE OF BLANK CASING USED: 5 Wrought iron 8 Concrete tile CASING JOINTS: Glued Clamped
 1 Steel 3 RMP (SR) 6 Asbestos-Cement 9 Other (specify below) Welded Fusion
 2 PVC 4 ABS 7 Fiberglass H.D. Polyethylene Threaded
 Blank casing diameter 3.14 in. to ft. Dia in. to ft. Dia in. to ft.
 Casing height above land surface 40 in., weight S.D.R. 11 160 PS/1 lbs./ft. Wall thickness or gauge No.
 TYPE OF SCREEN OR PERFORATION MATERIAL: None 7 PVC 10 Asbestos-Cement
 1 Steel 3 Stainless Steel 5 Fiberglass 8 RMP (SR) 11 Other (Specify)
 2 Brass 4 Galvanized Steel 6 Concrete tile 9 ABS 12 None used (open hole)
 SCREEN OR PERFORATION OPENINGS ARE: None 5 Gauzed wrapped 8 Saw cut 11 None (open hole)
 1 Continuous slot 3 Mill slot 6 Wire wrapped 9 Drilled holes
 2 Louvered shutter 4 Key punched 7 Torch cut 10 Other (specify) ft.
 SCREEN-PERFORATED INTERVALS: From ft. to ft., From ft. to ft.
 GRAVEL PACK INTERVALS: From ft. to ft., From ft. to ft.

6 GROUT MATERIAL: 1 Neat cement 2 Cement grout 3 Bentonite 4 Other
 Grout Intervals: From 180 ft. to 3 ft., From ft. to ft., From ft. to ft.
 What is the nearest source of possible contamination: NONE at time of drilling 10 Livestock pens 14 Abandoned water well
 1 Septic tank 4 Lateral lines 7 Pit privy 11 Fuel storage 15 Oil well/Gas well
 2 Sewer lines 5 Cess pool 8 Sewage lagoon 12 Fertilizer storage 16 Other (specify below)
 3 Watertight sewer lines 6 Seepage pit 9 Feedyard 13 Insecticide storage
 Direction from well? How many feet?

FROM	TO	LITHOLOGIC LOG	FROM	TO	PLUGGING INTERVALS
0	6	Soil & clay			
6	12	Limestone			
12	18	clay			4-180' BORES Plugged
18	25	Shale			
25	98	Limestone	180	3	High Solids bentonite
98	150	Shale			
150	162	Limestone			
162	180	Shale			

RECEIVED
 NOV 15 2004
 BUREAU OF WATER

7 CONTRACTOR'S OR LANDOWNER'S CERTIFICATION: This water well was (1) constructed, (2) reconstructed, or plugged under my jurisdiction and was completed on (mo/day/year) 11-2-04 and this record is true to the best of my knowledge and belief. Kansas Water Well Contractor's Licence No 561 This Water Well Record was completed on (mo/day/yr) 11-12-04 under the business name of Evans Energy Dev. Inc. by signature [Signature]

INSTRUCTIONS: Use typewriter or ball point pen. PLEASE PRESS FIRMLY and PRINT clearly. Please fill in blanks, underline or circle the correct answers. Send top three copies to Kansas Department of Health and Environment, Bureau of Water, Geology Section, 1000 SW Jackson St., Suite 420, Topeka, Kansas 66612-1367. Telephone 785-296-5522. Send one to WATER WELL OWNER and retain one for your records. Fee of \$5.00 for each completed well.