USE TYPEWRITER OR BALL POINT PEN-PRESS FIRMLY, PRINT CLEARLY.

WATER WELL RECORD
KSA 82a-1201-1215

Kansas Department of Health and Environment-Division of Environment
(Water well Contractors)
Topeka, Kansas 66620

1. Location of well:	County	Fraction	Section number	Township number	Range number
	Miami	NW 1/4 NW 1/4 SW 1/4	10	T 16S S	R 25E E/W

2. Distance and direction from nearest town or city: 5 mi. NE
Louisberg, Kansas
Street address of well location if in city:

3. Owner of well: Michael C. Stegeman
R.R. or street: 11403 W. 75th St.
City, state, zip code: Shawnee, Ks. 66214

4. Locate with "X" in section below:

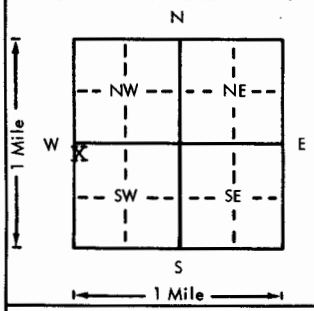

Sketch map:

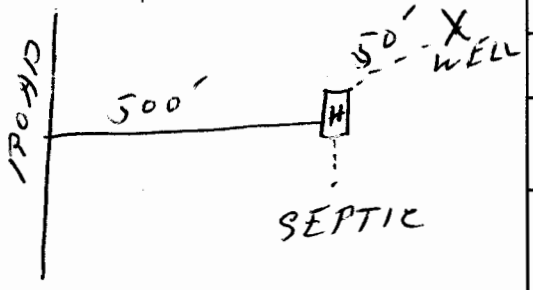

6. Bore hole dia. 81/4 DRY HOLE Completion date 9-76
Well depth ~~275~~ ft. 280'

7. X Cable tool DRY HOLE Rotary ___ Driven ___ Dug
___ Hollow rod ___ Jetted ___ Bored ___ Reverse rotary

8. Use: ___ Domestic DRY HOLE ___ Public supply ___ Industry
___ Irrigation ___ Air conditioning ___ Stock
___ Lawn ___ Oil field water ___ Other

9. Casing: Material ___ Height: Above or below
Threaded DRY HOLE Welded ___ Surface ___ in.
RMP ___ PVC ___ Weight ___ lbs./ft.
Dia. ___ in. to ___ ft. depth Wall Thickness: inches or
Dia. ___ in. to ___ ft. depth gage No. ___

5. Type and color of material	From	To
surface (	0	3
clay (yellow)	3	13
broken rock (brown)	13	23
shale(grey0	23	28
lime(grey)	28	35
shale(grey)	35	56
lime (lt.grey)	56	95
shale(dk.grey)	95	129
lime (grey)	129	142
shale(dark)	142	168
lime (grey)	168	173
shale (grey)	173	184
lime (lt.grey)	184	188
shale (grey)	188	196
lime (grey)	196	231
shale (dark)	231	235
lime (li.grey)	235	255
slate(black)	255	261
lime(grey)	261	266
shale (grey)	266	275
lime (grey)	275	280

DRY HOLE---PLUGGED

(Use a second sheet if needed)

10. Screen: Manufacturer's name DRY HOLE
Type ___ Dia. ___
Slot/gauze ___ Length ___
Set between ___ ft. and ___ ft.
___ ft. and ___ ft.
Gravel pack? ___ Size range of material ___

11. Static water level: DRY HOLE mo./day/yr.
___ ft. below land surface Date ___

12. Pumping level below land surfaces:
___ ft. after DRY HOLE hrs. pumping ___ g.p.m.
___ ft. after ___ hrs. pumping ___ g.p.m.
Estimated maximum yield ___ g.p.m.

13. Water sample submitted: DRY HOLE mo./day/yr.
___ Yes ___ No Date ___

14. Well head completion: DRY HOLE
___ Pitless adapter ___ Inches above grade

15. Well grouted? DRY HOLE
With: ___ Neat cement ___ Bentonite ___ Concrete
Depth: From ___ ft. to ___ ft.

16. Nearest source of possible contamination:
ft. DRY HOLE Direction ___ Type ___
Well disinfected upon completion? ___ Yes ___ No

17. Pump: ___ Not installed
Manufacturer's name DRY HOLE
Model number ___ HP ___ Volts ___
Length of drop pipe ___ ft. capacity ___ g.p.m.
Type:
___ Submersible ___ Turbine
___ Jet ___ Reciprocating
___ Centrifugal ___ Other

18. Elevation: 1080
Topography:
___ Hill
X Slope
___ Upland
___ Valley

19. Remarks: Customer is aware of State regulation and agrees to install a 4' square re-enforced concrete platform around top of well..
X Julia E Stegeman

20. Water well contractor's certification:
This well was drilled under my jurisdiction and this report is true to the best of my knowledge and belief.
F.E.Young Drilling 240
Business name License No.
Address 6355 Robinhood Ln.
Signed F.E. Young Date 9-76
Authorized representative

T 16 R 25E W Sec 10 1/4 NW 1/4 NW 1/4 SW 1/4

Forward the white, blue and pink copies to the Department of Health and Environment

Form WWC-5

MI-1023