USE TYPEWRITER OR BALL POINT PEN-PRESS FIRMLY, PRINT CLEARLY.

WATER WELL RECORD
KSA 82a-1201-1215

Kansas Department of Health and Environment-Division of Environment
(Water well Contractors)
Topeka, Kansas 66620

1. Location of well:	County	Fraction	Section number	Township number	Range number
	Dickinson	NE 1/4 NE 1/4 NE 1/4	31	T 16 S	R 3 (E) W

2. Distance and direction from nearest town or city: 4 South 3 West of Hope
Street address of well location if in city:

3. Owner of well: Abelt
R.R. or street: RR 1
City, state, zip code: Hope, Ks

4. Locate with "X" in section below:

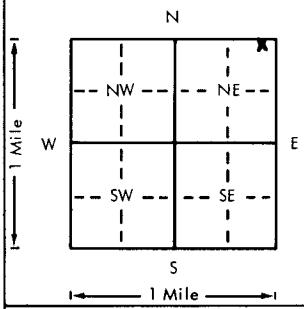

Sketch map:

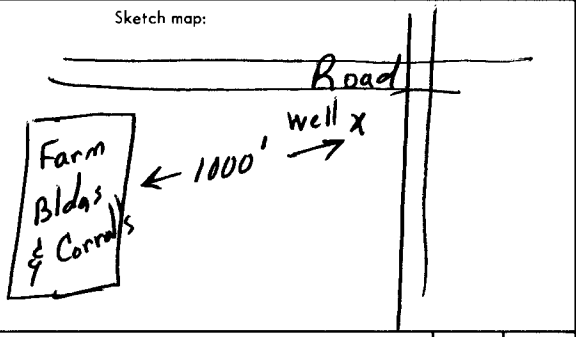

6. Bore hole dia. 6 3/4 in. Completion date 8-10-78
Well depth 81 ft.

7. __ Cable tool X Rotary __ Driven __ Dug
__ Hollow rod __ Jetted __ Bored __ Reverse rotary

8. Use: __ Domestic __ Public supply __ Industry
__ Irrigation __ Air conditioning X Stock
__ Lawn __ Oil field water __ Other

9. Casing: Material Pltc Height (Above) or below
Threaded ___ Welded Glu Surface 18 in.
RMP X PVC ___ Weight ___ lbs./ft.
Dia. 5 in. to 35 ft. depth Wall Thickness: inches or
Dia. ___ in. to ___ ft. depth gage No. .200

5. Type and color of material	From	To
Topsoil BK	0	3
Shale - Yel	3	13
Shale - Gray	13	19
Lime - Lite	19	20
Lime - Broken	20	21
Shale - Dirty Gray	21	25
Lime - Gray	25	27
Shale - Gray	27	29
Lime - TAN	29	30
Shale - Lite	30	35
Gyp Water	35	47
Lime - Gray	47	49
Shale Gray	49	59
Lime & Gyp	59	63
Shale - Gray	63	65
Lime - Gray	65	67
Shale - BLK	67	70
Lime - Gray	70	79
Shale - Green to Red	79	81

(Use a second sheet if needed)

10. Screen: Manufacturer's name Sunflower
Type RMP Dia. 5"
Slot gauze 18 Length 46'
Set between 35 ft. and 81 ft.
___ ft. and ___ ft.
Gravel pack? Yes Size range of material 1/8 - 3/8

11. Static water level: mo./day/yr.
30 ft. below land surface Date 8-10-78

12. Pumping level below land surfaces:
___ ft. after ___ hrs. pumping ___ g.p.m.
___ ft. after ___ hrs. pumping ___ g.p.m.
Estimated maximum yield 40gpm g.p.m.

13. Water sample submitted: mo./day/yr.
__ Yes X No Date ___

14. Well head completion:
__ Pitless adapter 18 Inches above grade

15. Well grouted? Yes
With: X Neat cement __ Bentonite __ Concrete
Depth: From 0 ft. to 13 ft.

16. Nearest source of possible contamination: Farm Yard
ft. 1000' Direction West Type
Well disinfected upon completion? X Yes __ No

17. Pump: X Not installed
Manufacturer's name ___
Model number ___ HP ___ Volts ___
Length of drop pipe ___ ft. capacity ___ g.p.m.
Type:
__ Submersible __ Turbine
__ Jet __ Reciprocating
__ Centrifugal __ Other

T 16 R 3 (E) W Sec 31 1/4 NE 1/4 NE 1/4 NE 1/4

18. Elevation:

Topography:
__ Hill
__ Slope
X Upland
__ Valley

19. Remarks:

20. Water well contractor's certification:
This well was drilled under my jurisdiction and this report is true to the best of my knowledge and belief.
Business name Zinn Water Well Drilg. License No. 218
Address Lost Springs, Ks
Signed Joseph A. Zinn Date 8-22-78
Authorized representative

Forward the white, blue and pink copies to the Department of Health and Environment

Form WWC-5

MI-1023