


1 LOCATION OF WATER WELL: County: DICKINSON Fraction: NW 1/4 NW 1/4 SE 1/4 Section Number: 2 Township Number: T 16S Range Number: R 4E

Distance and direction from nearest town or city street address of well if located within city?
2 North - 1/4 West - 1/2 South from Jct of US 77 & US 56 at Herington

2 WATER WELL OWNER: Delbert Presslor
 RR#, St. Address, Box #: 215 West Main
 City, State, ZIP Code: Herington, KS 67449
 Board of Agriculture, Division of Water Resources
 Application Number: X

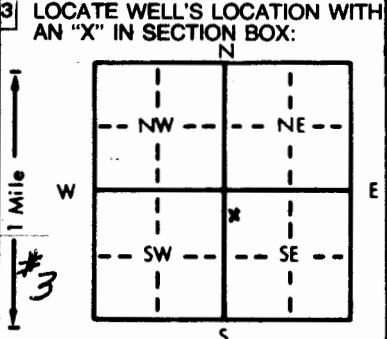

4 DEPTH OF COMPLETED WELL: 110 ft. ELEVATION: _____ ft.
 Depth(s) Groundwater Encountered 1. 99 ft. 2. _____ ft. 3. _____ ft.
 WELL'S STATIC WATER LEVEL: 48 ft. below land surface measured on mo/day/yr May 3 89
 Pump test data: Well water was _____ ft. after _____ hours pumping _____ gpm
 Est. Yield 35 gpm: Well water was _____ ft. after _____ hours pumping _____ gpm
 Bore Hole Diameter: 8 in. to 110 ft., and _____ in. to _____ ft.
 WELL WATER TO BE USED AS:
 5 Public water supply 8 Air conditioning 11 Injection well
 1 Domestic 3 Feedlot 6 Oil field water supply 9 Dewatering 12 Other (Specify below)
2 Irrigation 4 Industrial 7 Lawn and garden only 10 Monitoring well MINNOW FARM
 Was a chemical/bacteriological sample submitted to Department? Yes _____ No X; If yes, mo/day/yr sample was submitted _____
 Water Well Disinfected? Yes No

5 TYPE OF BLANK CASING USED:
 1 Steel 3 RMP (SR) 5 Wrought iron 8 Concrete tile CASING JOINTS: Glued X Clamped _____
2 PVC 4 ABS 6 Asbestos-Cement 9 Other (specify below) Welded _____
 7 Fiberglass Threaded _____
 Blank casing diameter 5 in. to 70 ft., Dia _____ in. to _____ ft., Dia _____ in. to _____ ft.
 Casing height above land surface 16 in., weight _____ lbs./ft. Wall thickness or gauge No. SDR 26
 TYPE OF SCREEN OR PERFORATION MATERIAL:
 1 Steel 3 Stainless steel 5 Fiberglass 8 RMP (SR) 10 Asbestos-cement
 2 Brass 4 Galvanized steel 6 Concrete tile 9 ABS 11 Other (specify) _____
 12 None used (open hole)
 SCREEN OR PERFORATION OPENINGS ARE:
 1 Continuous slot 3 Mill slot 5 Gauzed wrapped 8 Saw cut 11 None (open hole)
 2 Louvered shutter 4 Key punched 6 Wire wrapped 9 Drilled holes
 7 Torch cut 10 Other (specify) _____
 SCREEN-PERFORATED INTERVALS: From 70 ft. to 110 ft., From _____ ft. to _____ ft.
 From _____ ft. to _____ ft., From _____ ft. to _____ ft.
 GRAVEL PACK INTERVALS: From 25 ft. to 110 ft., From _____ ft. to _____ ft.
 From _____ ft. to _____ ft., From _____ ft. to _____ ft.

6 GROUT MATERIAL: 1 Neat cement 2 Cement grout 3 Bentonite 4 Other _____
 Grout Intervals: From 3 ft. to 25 ft., From _____ ft. to _____ ft., From _____ ft. to _____ ft.
 What is the nearest source of possible contamination:
 1 Septic tank 4 Lateral lines 7 Pit privy 10 Livestock pens 14 Abandoned water well
 2 Sewer lines 5 Cess pool 8 Sewage lagoon 11 Fuel storage 15 Oil well/Gas well
 3 Watertight sewer lines 6 Seepage pit 9 Feedyard 12 Fertilizer storage 16 Other (specify below)
 13 Insecticide storage OLD Rock Quarry Road
 Direction from well? South East How many feet? 200

FROM	TO	LITHOLOGIC LOG	FROM	TO	PLUGGING INTERVALS
0	2	Top Soil	88	93	LIME Gray Grainy
2	5	Shale TAN	93	96	LIME Gray Hard
5	8	Red Rock	96	97	Shale Gray
8	10	Shale lite TAN	97	99	Soft lite Gray Lime Gray Formation
10	11	Lime Gray	99	100	Soft lite Gray Formation
11	14	Shale Lite Green	100	104	LIME Hard Gray
14	28	LIME Gray	104	108	Shale Gray to Blue
28	30	Shale Yel	108	110	Shale Green Hard
30	36	LIME TAN			
36	47	Shale Yel			
47	52	LIME Gray / Flint			
52	61	Shale Green			
61	64	LIME Greenish Gray			
64	67	Shale Blue Green			
67	88	Red Rock & Green Shale			

* had conversation with Darrel Plummer Jun 1 89

7 CONTRACTOR'S OR LANDOWNER'S CERTIFICATION: This water well was 1 constructed, (2) reconstructed, or (3) plugged under my jurisdiction and was completed on (mo/day/year) May 3 89 and this record is true to the best of my knowledge and belief. Kansas Water Well Contractor's License No. 218 This Water Well Record was completed on (mo/day/yr) May 18 89 under the business name of ZINN Water Well Drlg by (signature) Joseph A. Zinn