


1 LOCATION OF WATER WELL: County: Dickinson Fraction: NW 1/4 NE 1/4 SE 1/4 Section Number: 2 Township Number: T 16S Range Number: R 4E

Distance and direction from nearest town or city street address of well if located within city?
2 North - 1/4 West - 1/2 South from Jct US-77 & US-56 at Herington

2 WATER WELL OWNER: Delbert Presslor
 RR#, St. Address, Box #: 215 West Main
 City, State, ZIP Code: Herington, Kansas 67449
 Board of Agriculture, Division of Water Resources
 Application Number: *

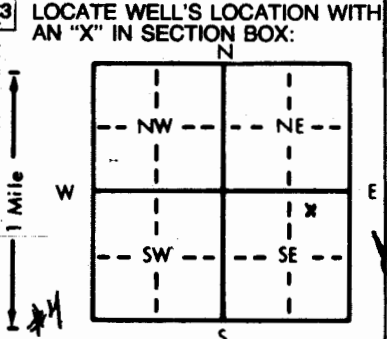

4 DEPTH OF COMPLETED WELL: 85 ft. ELEVATION: _____
 Depth(s) Groundwater Encountered 1. 54 ft. 2. _____ ft. 3. _____ ft.
 WELL'S STATIC WATER LEVEL 31.5 ft. below land surface measured on mo/day/yr May 5 89
 Pump test data: Well water was _____ ft. after _____ hours pumping _____ gpm
 Est. Yield 35 gpm: Well water was _____ ft. after _____ hours pumping _____ gpm
 Bore Hole Diameter: 8 in. to 8.5 ft., and _____ in. to _____ ft.
 WELL WATER TO BE USED AS:
 Domestic 3 Feedlot 6 Oil field water supply 9 Dewatering Other (Specify below) MINNOW FARM
 Irrigation 4 Industrial 7 Lawn and garden only 10 Monitoring well
 Was a chemical/bacteriological sample submitted to Department? Yes _____ No X; If yes, mo/day/yr sample was submitted _____
 Water Well Disinfected? Yes No

5 TYPE OF BLANK CASING USED:
 1 Steel 3 RMP (SR) 5 Wrought iron 8 Concrete tile CASING JOINTS: Glued X Clamped _____
 PVC 4 ABS 6 Asbestos-Cement 9 Other (specify below) Welded _____
 7 Fiberglass Threaded _____
 Blank casing diameter 5 in. to 4.5 ft., Dia _____ in. to _____ ft., Dia _____ in. to _____ ft.
 Casing height above land surface 16 in., weight _____ lbs./ft. Wall thickness or gauge No. SDR 20
 TYPE OF SCREEN OR PERFORATION MATERIAL:
 PVC 10 Asbestos-cement
 1 Steel 3 Stainless steel 5 Fiberglass 8 RMP (SR) 11 Other (specify) _____
 2 Brass 4 Galvanized steel 6 Concrete tile 9 ABS 12 None used (open hole)
 SCREEN OR PERFORATION OPENINGS ARE:
 1 Continuous slot 3 Mill slot 5 Gauzed wrapped Saw cut 11 None (open hole)
 2 Louvered shutter 4 Key punched 6 Wire wrapped 9 Drilled holes
 7 Torch cut 10 Other (specify) _____
 SCREEN-PERFORATED INTERVALS: From 45 ft. to 85 ft., From _____ ft. to _____ ft.
 From _____ ft. to _____ ft., From _____ ft. to _____ ft.
 GRAVEL PACK INTERVALS: From 2.5 ft. to 8.5 ft., From _____ ft. to _____ ft.
 From _____ ft. to _____ ft., From _____ ft. to _____ ft.

6 GROUT MATERIAL: Neat cement 2 Cement grout 3 Bentonite 4 Other _____
 Grout Intervals: From 3 ft. to 2.5 ft., From _____ ft. to _____ ft., From _____ ft. to _____ ft.
 What is the nearest source of possible contamination:
 1 Septic tank 4 Lateral lines 7 Pit privy 10 Livestock pens 14 Abandoned water well
 2 Sewer lines 5 Cess pool 8 Sewage lagoon 11 Fuel storage 15 Oil well/Gas well
 3 Watertight sewer lines 6 Seepage pit 9 Feedyard 12 Fertilizer storage 16 Other (specify below) OLD Rock Quarry Pond
 Direction from well? South East How many feet? 65

FROM	TO	LITHOLOGIC LOG	FROM	TO	PLUGGING INTERVALS
0	2	Top soil			
2	3	Clay Brn			
3	13	LIME TAN			
13	24	Shale			
24	29	LIME lite / Flint Blue			
29	37	Shale Yel			
37	45	LIME TAN			
45	54	Red Rock			
54	62	LIME lite Gray			* Had conversation with Darrel Plummer
62	67	Shale lite			
67	70	LIME Gray			
70	77	Shale Gray			
77	85	LIME Gray			

7 CONTRACTOR'S OR LANDOWNER'S CERTIFICATION: This water well was constructed, reconstructed, or plugged under my jurisdiction and was completed on (mo/day/year) May 5 89 and this record is true to the best of my knowledge and belief. Kansas Water Well Contractor's License No. 218 This Water Well Record was completed on (mo/day/yr) Jun 3 89 under the business name of ZINN Water Well Drlg by (signature) Joseph A. Zinn