


1 LOCATION OF WATER WELL: Fraction NE 1/4 NW 1/4 SE 1/4 Section Number 2 Township Number T 16 S Range Number R 4 EW
 County: DICKINSON

Distance and direction from nearest town or city street address of well if located within city?
2 North - 1/4 West - 1/2 South from Jct of US 77 & 56 at Herington

2 WATER WELL OWNER: Delbert Presslor
 RR#, St. Address, Box #: 215 West Main
 City, State, ZIP Code: Herington, KS 67449
 Board of Agriculture, Division of Water Resources
 Application Number:

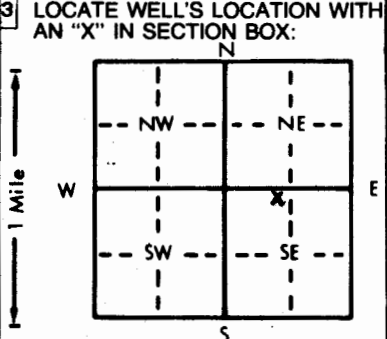

4 DEPTH OF COMPLETED WELL: 81 ft. ELEVATION: ft.
 Depth(s) Groundwater Encountered 1. 45 ft. 2. ft. 3. ft.
 WELL'S STATIC WATER LEVEL 31 ft. below land surface measured on mo/day/yr Aug. 7 89
 Pump test data: Well water was ft. after hours pumping gpm
 Est. Yield 25 gpm: Well water was ft. after hours pumping gpm
 Bore Hole Diameter: 8 in. to 23 ft., and 6 1/2 in. to 81 ft.
 WELL WATER TO BE USED AS:
 1 Domestic 3 Feedlot 6 Oil field water supply 9 Dewatering (12) Other (Specify below)
 2 Irrigation 4 Industrial 7 Lawn and garden only 10 Monitoring well MINNOW WATER
 Was a chemical/bacteriological sample submitted to Department? Yes.....No X.....; If yes, mo/day/yr sample was submitted
 Water Well Disinfected? (Yes) No

5 TYPE OF BLANK CASING USED:
 1 Steel 3 RMP (SR) 5 Wrought iron 8 Concrete tile CASING JOINTS: Glued X Clamped
(2) PVC 4 ABS 6 Asbestos-Cement 9 Other (specify below) Welded
 7 Fiberglass Threaded
 Blank casing diameter 5 in. to 4.5 ft., Dia. in. to ft., Dia. in. to ft.
 Casing height above land surface 18 in., weight lbs./ft. Wall thickness or gauge No. SDA-26
 TYPE OF SCREEN OR PERFORATION MATERIAL:
 1 Steel 3 Stainless steel 5 Fiberglass (7) PVC 10 Asbestos-cement
 2 Brass 4 Galvanized steel 6 Concrete tile 8 RMP (SR) 11 Other (specify)
 12 None used (open hole)
 SCREEN OR PERFORATION OPENINGS ARE:
 1 Continuous slot 3 Mill slot 5 Gauzed wrapped (8) Saw cut 11 None (open hole)
 2 Louvered shutter 4 Key punched 6 Wire wrapped 9 Drilled holes
 7 Torch cut 10 Other (specify)
 SCREEN-PERFORATED INTERVALS: From 45 ft. to 81 ft., From ft. to ft.
 From ft. to ft., From ft. to ft.
 GRAVEL PACK INTERVALS: From NONE ft. to ft., From ft. to ft.
 From ft. to ft., From ft. to ft.

6 GROUT MATERIAL: (1) Neat cement 2 Cement grout 3 Bentonite 4 Other
 Grout Intervals: From 0 ft. to 23 ft., From ft. to ft., From ft. to ft.
 What is the nearest source of possible contamination:
 1 Septic tank 4 Lateral lines 7 Pit privy 10 Livestock pens 14 Abandoned water well
 2 Sewer lines 5 Cess pool 8 Sewage lagoon 11 Fuel storage 15 Oil well/Gas well
 3 Watertight sewer lines 6 Seepage pit 9 Feedyard 12 Fertilizer storage 16 Other (specify below)
OLD Quarry Pond
 13 Insecticide storage
 Direction from well? EAST How many feet? 70

FROM	TO	LITHOLOGIC LOG	FROM	TO	PLUGGING INTERVALS
0	5	Top Soil			
5	10	LIME TAN			
10	15	Shale Yel			
15	17	LIME TAN Soft			
17	22	LIME TAN			
22	24	Shale Yel			
24	27	LIME TAN			
27	32	Shale Yel			
32	35	LIME TAN			
35	44	Red Rock			
44	48	LIME Broken Gray			
48	54	Shale Yellowis			
54	59	Shale Gray			
59	76	Red Rock			
76	81	LIME Lite Gray			

7 CONTRACTOR'S OR LANDOWNER'S CERTIFICATION: This water well was (1) constructed, (2) reconstructed, or (3) plugged under my jurisdiction and was completed on (mo/day/year) Aug 7 89 and this record is true to the best of my knowledge and belief. Kansas Water Well Contractor's License No. 218 This Water Well Record was completed on (mo/day/yr) 29 Aug 89 under the business name of Zinn Water Well Drlg by (signature) Joseph A. Zinn

INSTRUCTIONS: Use typewriter or ball point pen. PLEASE PRESS FIRMLY and PRINT clearly. Please fill in blanks, underline or circle the correct answers. Send top three copies to Kansas Department of Health and Environment, Bureau of Water Protection, Topeka, Kansas 66620-7320. Telephone: 913-296-5514. Send one to WATER WELL OWNER and retain one for your records.