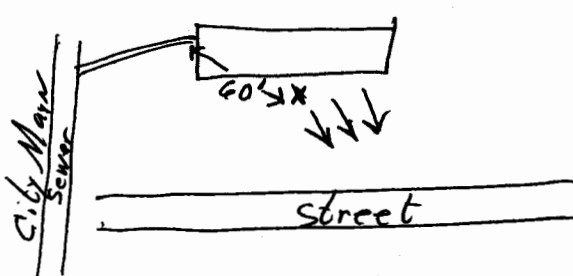


USE TYPEWRITER OR BALL POINT PEN—PRESS FIRMLY, PRINT CLEARLY.

WATER WELL RECORD  
KSA 82a-1201-1215

Kansas Department of Health and Environment—Division of Environment  
(Water well Contractors)  
Topeka, Kansas 66620

1. Location of well:		County <b>Dickinson</b>	Fraction <b>SE 1/4 NE 1/4 NW 1/4</b>	Section number <b>12</b>	Township number <b>T 16 S R 4 EW</b>	Range number <b>4 EW</b>
2. Distance and direction from nearest town or city: Street address of well location if in city: <b>503 N G Herington</b>				3. Owner of well: <b>Jack W Beisel</b> R.R. or street: <b>503 North G</b> City, state, zip code: <b>Herington Kan</b>		
4. Locote with "X" in section below: N W E S 1 Mile 1 Mile		Sketch map: 			6. Bore hole dia. <b>6 1/4</b> in. Completion date <b>7-31-77</b> Well depth <b>80</b> ft.	
5. Type and color of material		From	To	7. <input checked="" type="checkbox"/> Cable tool ___ Rotary ___ Driven ___ Dug ___ Hollow rod ___ Jetted ___ Bored ___ Reverse rotary		
Topsoil Blk		0	5	8. Use: ___ Domestic ___ Public supply ___ Industry ___ Irrigation ___ Air conditioning ___ Stock <input checked="" type="checkbox"/> Lawn ___ Oil field water ___ Other		
Broken Lime - Yel		5	10	9. Casing: Material <b>Piles</b> Height <b>Above</b> or below Threaded ___ Welded <b>galv</b> Surface <b>14</b> in. RMP <input checked="" type="checkbox"/> PVC ___ Weight ___ lbs./ft. Dia <b>5</b> in. to <b>60</b> ft. depth Wall Thickness: inches or Dia. ___ in. to ___ ft. depth Gage No. <b>1200</b>		
Lime - Yel		10	17	10. Screen: Manufacturer's name <b>Sundtlower</b> Type <b>RMP</b> Dia. <b>5"</b> Shot/gauze <b>1/16</b> Length <b>20</b> Set between <b>60</b> ft. and <b>80</b> ft. ft. and ___ ft. Gravel pack? <b>Yes</b> Size range of material <b>1/8-3/8</b>		
Shale - Lite		17	23	11. Static water level: ___ mo./day/yr. <b>20</b> ft. below land surface Date <b>7-31-77</b>		
Lime - Yel		23	27	12. Pumping level below land surfaces: ___ ft. after ___ hrs. pumping ___ g.p.m. ___ ft. after ___ hrs. pumping ___ g.p.m. Estimated maximum yield <b>20</b> g.p.m.		
Shale - Yel		27	36	13. Water sample submitted: ___ mo./day/yr. Yes ___ No <input checked="" type="checkbox"/> Date ___		
Red Rock - Red		36	43	14. Well head completion: <input checked="" type="checkbox"/> Pitless adapter ___ <b>14</b> Inches above grade		
Lime - Yel		43	45	15. Well grouted? <b>Yes</b> With: ___ Neat cement ___ Bentonite <input checked="" type="checkbox"/> Concrete Depth: From <b>3</b> ft. to <b>14</b> ft.		
Shale - Yel		45	52	16. Nearest source of possible contamination: <b>Sewer</b> ft. <b>60</b> Direction <b>NW</b> Type <b>LINE</b> Well disinfected upon completion? <input checked="" type="checkbox"/> Yes ___ No		
Red Rock - Red		52	69	17. Pump: Not installed Manufacturer's name <b>Gould</b> Model number <b>10E3</b> HP <b>1/2</b> Volts <b>230</b> Length of drop pipe <b>27</b> ft. capacity <b>10</b> g.p.m. Type: <input checked="" type="checkbox"/> Submersible ___ Turbine ___ Jet ___ Reciprocating ___ Centrifugal ___ Other		
Shale - Yel		69	76	18. Elevation:		
Lime Yel		76	80	19. Remarks:		
(Use a second sheet if needed)				20. Water well contractor's certification: This well was drilled under my jurisdiction and this report is true to the best of my knowledge and belief. <b>Zinn Water Well Drilling 218</b> Business name License No. ___ Address <b>Lost Springs, Kan</b> Signed <b>Joseph A. Zinn</b> Date <b>8-5-77</b> Authorized representative		

Forward the white, blue and pink copies to the Department of Health and Environment

Form WWC-5

T 16 S R 4 EW  
W 12 SE  
1/4 1/4 1/4