


LOCATION OF WATER WELL: Fraction ne 1/4 ne 1/4 sw 1/4 Section Number 12 Township Number T 16 S Range Number R 7 E
 County: Dickens
 Distance and direction from nearest town or city street address of well if located within city?
815 North B. St. Herington Ks.

WATER WELL OWNER: R. D. Longabaugh
 RR#, St. Address, Box #: 815 N.B.
 City, State, ZIP Code: Herington Ks.

Board of Agriculture, Division of Water Resources
 Application Number:

LOCATE WELL'S LOCATION WITH AN "X" IN SECTION BOX:

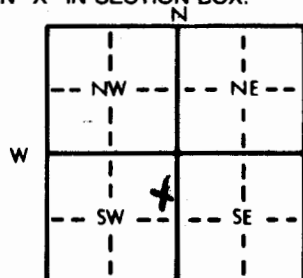

4 DEPTH OF COMPLETED WELL: 57 ft. ELEVATION:

Depth(s) Groundwater Encountered 37 ft. 2. 5-3-22 ft. 3.

WELL'S STATIC WATER LEVEL 37 ft. below land surface measured on mo/day/yr

Pump test data: Well water was 7 ft. after 7 hours pumping 5-3-22 gpm

Est. Yield 7 gpm Well water was 15 ft. after 7 hours pumping 5-3-22 gpm

Bore Hole Diameter 9 in. to 15 ft., and 7 in. to 57 ft.

WELL WATER TO BE USED AS: 5 Public water supply 8 Air conditioning 11 Injection well
 1 Domestic 3 Feedlot 6 Oil field water supply 9 Dewatering 12 Other (Specify below)
 2 Irrigation 4 Industrial Water for irrigation 10 Observation well

Was a chemical/bacteriological sample submitted to Department? Yes X No X; If yes, mo/day/yr sample was submitted

Water Well Disinfected? Yes X No

TYPE OF BLANK CASING USED:

- 1 Steel 3 RMP (SR)
 2 PVC 4 ABS

- 5 Wrought iron 8 Concrete tile
 6 Asbestos-Cement 9 Other (specify below)
 7 Fiberglass

CASING JOINTS: Glued X Clamped
 Welded
 Threaded

Blank casing diameter 5 in. to 37 ft., Dia 12 in. to 160 lbs./ft. Wall thickness or gauge No. 160

Casing height above land surface 12 in., weight 12 lbs./ft.

TYPE OF SCREEN OR PERFORATION MATERIAL:

- 1 Steel 3 Stainless steel
 2 Brass 4 Galvanized steel

- 5 Fiberglass 8 RMP (SR)
 6 Concrete tile 9 ABS

- 7 PVC 10 Asbestos-cement
 11 Other (specify)
 12 None used (open hole)

SCREEN OR PERFORATION OPENINGS ARE:

- 1 Continuous slot 3 Mill slot
 2 Louvered shutter 4 Key punched

- 5 Gauzed wrapped
 6 Wire wrapped
 7 Torch cut

- 8 Saw cut 11 None (open hole)
 9 Drilled holes
 10 Other (specify)

SCREEN-PERFORATED INTERVALS: From 37 ft. to 57 ft., From 37 ft. to 57 ft.




GROUT MATERIAL:

- 1 Neat cement 2 Cement grout 3 Bentonite 4 Other

Grout intervals: From 3 ft. to 13 ft., From 3 ft. to 13 ft., From 3 ft. to 13 ft.

What is the nearest source of possible contamination:

- 1 Septic tank 4 Lateral lines 7 Pit privy
 2 Sewer lines 5 Cess pool 8 Sewage lagoon
 3 Watertight sewer lines 6 Seepage pit 9 Feedyard

- 10 Livestock pens 14 Abandoned water well
 11 Fuel storage 15 Oil well/Gas well
 12 Fertilizer storage 16 Other (specify below)
 13 Insecticide storage

Direction from well? S

How many feet? 20

FROM	TO	LITHOLOGIC LOG	FROM	TO	LITHOLOGIC LOG
0	3	Top Soil			
3	35	lime Stone + Shale			
35	45	Gray Shale + Clay			
45	52	yellow Shale			
52	53	Water			
53	56	lime Stone			
56	57	Red Shale			

CONTRACTOR'S OR LANDOWNER'S CERTIFICATION: This water well was (1) constructed (2) reconstructed, or (3) plugged under my jurisdiction and was completed on (mo/day/year) 5-3-22 and this record is true to the best of my knowledge and belief. Kansas

Water Well Contractor's License No. 120 This Water Well Record was completed on (mo/day/yr) 5-3-22


INSTRUCTIONS: Use typewriter or ball point pen, PLEASE PRESS FIRMLY and PRINT clearly. Please fill in blanks, underline or circle the correct answers. Send top three copies to Kansas Department of Health and Environment, Division of Environment, Environmental Geology Section, Topeka, KS 66620. Send one to WATER WELL OWNER and retain one for your records.