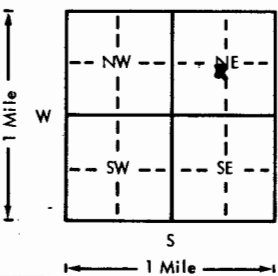
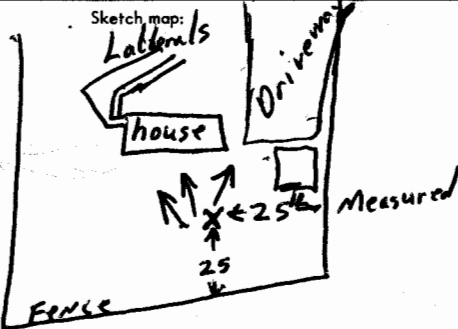


USE TYPEWRITER OR BALL POINT PEN-PRESS FIRMLY, PRINT CLEARLY.

WATER WELL RECORD
KSA 82a-1201-1215

Kansas Department of Health and Environment-Division of Environment
(Water well Contractors)
Topeka, Kansas 66620

1. Location of well:		County Dickinson	Fraction NE 1/4 SW 1/4 NE 1/4	Section number 16	Township number T 16 S R 4	Range number 4		
2. Distance and direction from nearest town or city: West of Herington 2 mile Street address of well location if in city:				3. Owner of well: Jay Venable R.R. or street: Lake Herington City, state, zip code: Herington Kan				
4. Locate with "X" in section below: 				Sketch map: 			6. Bore hole dia. 6 1/4 in. Completion date 6-5-77 Well depth 55 ft.	
5. Type and color of material				From		To		
				Topsoil - Blk		0 3		Type RMP Dia. 5"
Lime - wht				3 5		Slot/gauze 18 Length 33'		
Red Rock				5 9		Set between 22 ft. and 55 ft.		
Shale - Gray				9 12		Gravel pack? NO Size range of material _____		
Broken Lime - wht				12 14		11. Static water level: _____ mo./day/yr. 20 ft. below land surface Date 6-5-77		
Lime - wht				14 16		12. Pumping level below land surfaces: _____ ft. after _____ hrs. pumping _____ g.p.m. _____ ft. after _____ hrs. pumping _____ g.p.m. Estimated maximum yield 20 g.p.m.		
Shale - Yel				16 18		13. Water sample submitted: _____ mo./day/yr. Yes <input type="checkbox"/> No <input checked="" type="checkbox"/> Date _____		
Lime - Yel				18 21		14. Well head completion: _____ Pitless adapter 14 Inches above grade		
Lime - wht				21 28		15. Well grouted? Yes With: _____ Neat cement _____ Bentonite <input checked="" type="checkbox"/> Concrete Depth: From 3 ft. to 14 ft.		
Shale - Yel				28 36		16. Nearest source of possible contamination: ft. 60 Direction NW Type Sewage Well disinfected upon completion? <input checked="" type="checkbox"/> Yes _____ No		
Shale - Blue (more Gray)				36 41		17. Pump: <input checked="" type="checkbox"/> Not installed Manufacturer's name _____ Model number _____ HP _____ Volts _____ Length of drop pipe _____ ft. capacity _____ g.p.m. Type: _____ Submersible _____ Turbine _____ Jet _____ Reciprocating _____ Centrifugal _____ Other		
Lime - Yel				41 48		20. Water well contractor's certification: This well was drilled under my jurisdiction and this report is true to the best of my knowledge and belief. Zinn Water Well Drilling 210 Business name _____ License No. _____ Address Lost Springs, Kan Signed Joseph A. Zinn Date 6-5-77 Authorized representative		
Shale - Blue				48 54				
Lime - wht				54 55				
18. Elevation:		19. Remarks: 4'x4'x4" thick concrete slab installed around well will be responsibility of Customer. He knows this is a regulation. J. Venable						
Topography: <input type="checkbox"/> Hill <input checked="" type="checkbox"/> Slope <input type="checkbox"/> Upland <input type="checkbox"/> Valley								

T 16 S R 4 W 4 NE SW NE

Forward the white, blue and pink copies to the Department of Health and Environment

*Form WWC-5