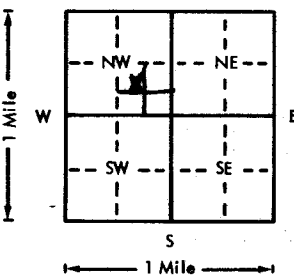
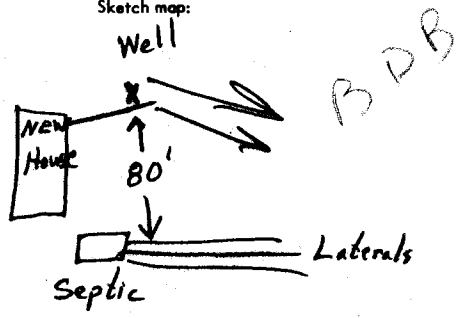


USE TYPEWRITER OR BALL
POINT PEN-PRESS FIRMLY,
PRINT CLEARLY.

WATER WELL RECORD
KSA 82a-1201-1215

Kansas Department of Health and
Environment-Division of Environment
(Water well Contractors)
Topeka, Kansas 66620

1. Location of well:		County Dickinson	Fraction NW 1/4 SE 1/4 NW 1/4	Section number 24	Township number T 16 S	Range number R 4 E
2. Distance and direction from nearest town or city: 1 1/2 mile South of Herington, Kan		3. Owner of well: Jim Pendlay R.R. or street: City, state, zip code: Herington, Kansas				
4. Locate with "X" in section below:		Sketch map:				
						
5. Type and color of material		From	To	6. Bore hole dia. 6 1/4 in. Completion date 11-27-75 Well depth 61 ft.		
Top - Blk		0	4	7. ☒ Cable tool ☐ Rotary ☐ Driven ☐ Dug ☐ Hollow rod ☐ Jetted ☐ Bored ☐ Reverse rotary		
Clay - Brn		4	10	8. Use: ☒ Domestic ☐ Public supply ☐ Industry ☐ Irrigation ☐ Air conditioning ☐ Stock ☐ Lawn ☐ Oil field water ☐ Other		
LIME Broken - wht		10	14	9. Casing: Material RMP Height Above or below Threaded ☐ Welded ☒ Surface 6 ft in. RMP ☒ PVC ☐ Weight ☐ lbs./ft. Dia. 5 in. to 49 ft. depth Wall Thickness: inches or Dia. ☐ in. to ☐ ft. depth gage No. 1200		
LIME Hard solid - wht		14	19	10. Screen: Manufacturer's name Jess & Lowell Type RMP Dia. 5" ☒ gauze 1/8" Length 12' Set between 49 ft. and 61 ft. ft. and ft. Gravel pack? NO Size range of material		
LIME Broken - wht		19	25	11. Static water level: ☐ mo./day/yr. 30 ft. below land surface Date 11-27-75		
LIME Solid - wht		25	30	12. Pumping level below land surfaces: ft. after hrs. pumping g.p.m. ft. after hrs. pumping g.p.m. Estimated maximum yield 20 g.p.m.		
Shale - Gray		30	32	13. Water sample submitted: ☐ Yes ☒ No Date		
LIME - Gray		32	41	14. Well head completion: ☐ Pitless adapter 6 ft inches above grade		
Shale - Gray		41	49	15. Well grouted? yes With: ☐ Neat cement ☐ Bentonite ☒ Concrete Depth: From 0 ft. to 10 ft.		
LIME - wht H2O 49		49	52	16. Nearest source of possible contamination: ft. 80 Direction S Type Septic Well disinfected upon completion? ☒ Yes ☐ No		
Shale - Lite Blu		52	61	17. Pump: ☒ Not installed Manufacturer's name Model number HP Volts Length of drop pipe ft. capacity g.p.m. Type: ☐ Submersible ☐ Turbine ☐ Jet ☐ Reciprocating ☐ Centrifugal ☐ Other		
(Use a second sheet if needed)						
18. Elevation:	19. Remarks: Concret slab to be installed by plumber before back fill		20. Water well contractor's certification: This well was drilled under my jurisdiction and this report is true to the best of my knowledge and belief. Zinn Water Well Drilling 218 Business name License No. Address Lost Springs, Kan Signed Joseph A. Zinn Date 12-12-75 Authorized representative			
Topography: ☐ Hill ☒ Slope ☐ Upland ☐ Valley						

Forward the white, blue and pink copies to the Department of Health and Environment

Form WWC-5