

1 LOCATION OF WATER WELL: County: <b>Dickinson</b>	Fraction <b>NE 1/4 NW 1/4 SE 1/4</b>	Section Number <b>11</b>	Township Number <b>T 16 S</b>	Range Number <b>R 4</b> <b>(E/W)</b>
---	---	-----------------------------	----------------------------------	---

Distance and direction from nearest town or city street address of well if located within city?


**500 N 7th St - Herington, KS Co-Op**

2 WATER WELL OWNER: **Agri Producers, Inc.**

RR#, St. Address, Box # : **500 N 7th St**  
City, State, ZIP Code : **Herington, KD 67449**

Board of Agriculture, Division of Water Resources  
Application Number:

3 LOCATE WELL'S LOCATION WITH AN "X" IN SECTION BOX:

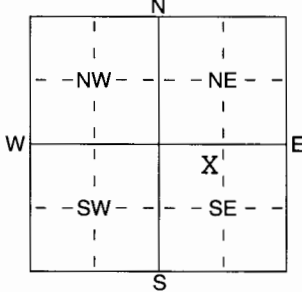

4 DEPTH OF COMPLETED WELL **.87** ft. ELEVATION:

Depth(s) Groundwater Encountered 1 **1** ft. 2 ..... ft. 3 **6-9-05** ft.  
 WELL'S STATIC WATER LEVEL **13.06** ft. below land surface measured on mo/day/yr .....  
 Pump test data: Well water was ..... ft. after ..... hours pumping ..... gpm  
 Est. Yield ..... gpm: Well water was ..... ft. after ..... hours pumping ..... gpm  
 WELL WATER TO BE USED AS:  
 1 Domestic 3 Feedlot 5 Public water supply 6 Oil field water supply 7 Domestic (lawn & garden) 8 Air conditioning 9 Dewatering 10 **Monitoring well** 11 Injection well 12 Other (Specify below)

Was a chemical/bacteriological sample submitted to Department? Yes ..... No **X** .....  
Water Well Disinfected? Yes ..... No **X** .....

5 TYPE OF BLANK CASING USED:

1 **Steel** 2 **PVC** 3 RMP (SR) 4 ABS 5 Wrought iron 6 Asbestos-Cement 7 Fiberglass 8 Concrete tile 9 Other (specify below)  
 CASING JOINTS: Glued ..... Clamped .....  
 Welded **screwed** ..... Threaded .....  
 Blank casing diameter ..... 5 ..... in. to ..... 8.2 ..... ft., Dia ..... in. to ..... ft., Dia ..... in. to ..... ft.  
 Casing height above land surface ..... 3.0 ..... in., weight ..... lbs./ft. Wall thickness or gauge No **81 40**

TYPE OF SCREEN OR PERFORATION MATERIAL:

1 Steel 2 Brass 3 Stainless Steel 4 Galvanized Steel 5 Fiberglass 6 Concrete tile 7 **PVC** 8 RMP (SR) 9 ABS 10 Asbestos-Cement 11 Other (Specify) ..... 12 None used (open hole)

SCREEN OR PERFORATION OPENINGS ARE:

1 Continuous slot 2 Louvered shutter 3 **Mill slot** 4 Key punched 5 Gauzed wrapped 6 Wire wrapped 7 Torch cut 8 Saw cut 9 Drilled holes 10 Other (specify) ..... 11 None (open hole)

SCREEN-PERFORATED INTERVALS: From **87** ft. to **82** ft., From ..... ft. to ..... ft.

GRAVEL PACK INTERVALS: From **N/A** ft. to **shale boot** ft., From ..... ft. to ..... ft.

6 GROUT MATERIAL: 1 Neat cement 2 Cement grout 3 **Bentonite** 4 Other .....

Grout Intervals: From **82** ft. to **3** ft., From ..... ft. to ..... ft., From ..... ft. to ..... ft.

What is the nearest source of possible contamination:  
 1 Septic tank 2 Sewer lines 3 Watertight sewer lines 4 Lateral lines 5 Cess pool 6 Seepage pit 7 Pit privy 8 Sewage lagoon 9 Feedyard 10 Livestock pens 11 Fuel storage 12 **Fertilizer storage** 13 Insecticide storage 14 Abandoned water well 15 Oil well/Gas well 16 Other (specify below)

Direction from well? **West** How many feet? **75**

FROM	TO	LITHOLOGIC LOG	FROM	TO	PLUGGING INTERVALS
0	17	clays	87	82	Native Materials
17	44	limestone	82	3	3/8 bentonite chips
44	50	gray clay and shale	3	0	clay
50	87	red clay			

7 CONTRACTOR'S OR LANDOWNER'S CERTIFICATION: This water well was (1) constructed, (2) reconstructed, or (3) plugged under my jurisdiction and was completed on (mo/day/year) **6/02/05** and this record is true to the best of my knowledge and belief. Kansas Water Well Contractor's Licence No **665** This Water Well Record was completed on (mo/day/yr) **6/10/05**

under the business name of **Pratt Well Environmental** by (signature) *Pratt Well Environmental*