


1 LOCATION OF WATER WELL:		Fraction		Section Number		Township Number		Range Number	
County:	Dickinson	SW ¼	SW ¼	SE ¼	12	T 16 S	R 4 E		

Distance and direction from nearest town or city street address of well if located within city?	
-------------------------------------------------------------------------------------------------	--

400 E. Trapp, Herington, KS

2	WATER WELL OWNER: Tim Ryff	
RR#, St. Address, Box #	: 805 Hawk Rd.	Board of Agriculture, Division of Water Resources
City, State, ZIP Code	: Hope, KS 67451	Application Number:

3	LOCATE WELL'S LOCATON WITH AN "X" IN SECTION BOX:	4	DEPTH OF COMPLETED WELL	30	ft. ELEVATION:	1369.40
---	---------------------------------------------------	---	-------------------------	----	----------------	---------

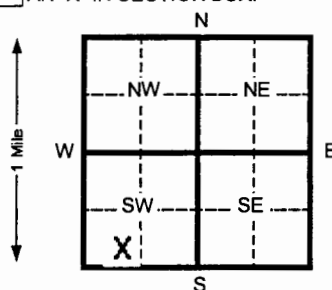

4 DEPTH OF COMPLETED WELL		30		ft. ELEVATION:		1369.40	
Depth(s) Groundwater Encountered		11.5		20		ft. 2 ft. 3 ft.	
WELL'S STATIC WATER LEVEL		18.73		ft. below land surface measured on		08/29/11	
Pump test data:		Well water was		Ft. after		hours pumping Gpm	
Est. Yield		Gpm: Well water was		Ft. after		Hours pumping Gpm	
Bore Hole Diameter		6.5		In. to 30		ft. and in. to ft.	
WELL WATER TO BE USED AS:		5 Public water supply		8 Air conditioning		11 Injection well	
1 Domestic 3 Feed lot		6 Oil field water supply		9 Dewatering		12 Other (Specify below)	
2 Irrigation 4 Industrial 7 Lawn and garden (domestic)		10		Monitoring well		MW-6	
Was a chemical/bacteriological sample submitted to Department? Yes No <input checked="" type="checkbox"/> If yes, mo/day/yr sample was Submitted							
Water Well Disinfected? Yes No <input checked="" type="checkbox"/>							

5 TYPE OF BLANK CASING USED:		5 Wrought Iron	8 Concrete tile	CASING JOINTS: Glued _____ Clamped _____	
1 Steel	3 RMP (SR)	6 Asbestos-Cement	9 Other (specify below)	Welded _____	
2 PVC	4 ABS	7 Fiberglass		Threaded	X

Blank casing diameter 2 in. to 15 Ft., Dia in. to ft.
Casing height above land surface **FLUSH** In., weight **SCH 40** Lbs./ft. Wall thickness or gauge No.

TYPE OF SCREEN OR PERFORATION MATERIAL:			7	10
1 Steel	3 Stainless steel	5 Fiberglass	PVC	Asbestos-cement
2 Brass	4 Galvanized steel	6 Concrete tile	8 RMP (SR)	11 Other (specify) _____
			9 ABS	12 None used (open hole)

SCREEN OR PERFORATION OPENINGS ARE:

1 Continuous slot	3 Mill slot	5 Gauzed wrapped	8 Saw cut	11 None (open hole)
2 Lowered shutter	4 Key punched	6 Wire wrapped	9 Drilled holes	
		7 Torch cut	10 Other (specify)	

2	2	4	7	10
2	4	7	10	Other (specify)
SCREEN-PERFORATED INTERVALS:	From 15 ft. to	30 ft. From	ft. to	ft.
	From ft. to	ft. From	ft. to	Ft.
SAND PACK INTERVALS:	From 13 ft. to	30 ft. From	ft. to	Ft.
	From ft. to	ft. From	ft. to	Ft.

		From		ft. to		ft. From		ft. to		ft.		
6	GROUT MATERIAL:	1 Neat cement		2 Cement grout		3 Bentonite		4 Other				
Grout Interval	Feet	0.5	ft. to	11	ft.	11	ft.	13	ft.	From	ft. to	ft.

What is the nearest source of possible contamination:					
1 Septic tank	4 Lateral lines	7 Pit privy	10 Livestock pens	14 Abandoned water well	
2 Sewer lines	5 Cess pool	8 Sewage lagoon	11 Fuel storage	15 Oil well/ Gas well	
3 Water distribution lines	6 Sewage pit	9 Feedyard	12 Fertilizer storage	16 Other (specify below)	
			13 Insecticide storage	Contaminated Site	

3 Watertight sewer lines	6 Seepage pit	9 Feedyard	13 Insecticide storage	Contaminated Site
Direction from well?			How many feet?	

[illegible]

7. CONTRACTOR'S OR LANDOWNER'S CERTIFICATION: This water well was (x) constructed, (2) reconstructed, or (3) plugged under my jurisdiction and was completed on (mo/day/yr) 08/25/11. And this record is true to the best of my knowledge and belief. Kansas Water Well Contractor's License No. 585. This Water Well Record was completed on (mo/day/yr) 09/12/11 under the business name of Associated Environmental, Inc. By (signature) Bradley J. Johnson

INSTRUCTIONS: Please fill in blanks and circle the correct answers. Send three copies to Kansas Department of Health and Environment, Bureau of Water Topeka, Kansas 66620-0001. Telephone: 913-296-5545. Send one to WATER WELL OWNER and retain one for your records.

OFFICE USE ONLY

T

2

SEC