

WATER WELL RECORD Form WWC-5


Original Record Correction Change in Well Use

Division of Water Resources App. No.

Well ID

1 LOCATION OF WATER WELL: County: Dickinson Fraction 1/4 Sec 1/4 NE 1/4 Sec 4 Section Number 31 Township Number T 16 S Range Number R 7 E E W

2 WELL OWNER: Last Name: Cady First: Ferry Street or Rural Address where well is located (if unknown, distance and direction from nearest town or intersection): If at owner's address, check here:
 Business Address: 234 Tanglewood
 City: Marion State: KS ZIP: 66661 2 E 1 1/4 N Ramona

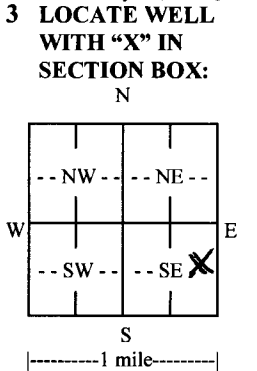

4 DEPTH OF COMPLETED WELL: 90 ft.
 Depth(s) Groundwater Encountered: 1) 43 ft.
 2) ft. 3) ft., or 4) Dry Well
 WELL'S STATIC WATER LEVEL: 15 ft.
 below land surface, measured on (mo-day-yr)
 above land surface, measured on (mo-day-yr) 4-2-15
 Pump test data: Well water was ft.
 after hours pumping gpm
 Well water was ft.
 after hours pumping gpm
 Estimated Yield: 3 gpm
 Bore Hole Diameter: 8 1/2 in. to 2 1/2 in. and
7 in. to 90 ft.

5 Latitude: (decimal degrees)
Longitude: (decimal degrees)
 Datum: WGS 84 NAD 83 NAD 27
 Source for Latitude/Longitude:
 GPS (unit make/model:)
 (WAAS enabled? Yes No)
 Land Survey Topographic Map
 Online Mapper:
6 Elevation: ft. Ground Level TOC
 Source: Land Survey GPS Topographic Map
 Other

7 WELL WATER TO BE USED AS:

1. Domestic: Household Lawn & Garden Livestock Irrigation Feedlot Industrial Water Trees

2. Public Water Supply: well ID
 3. Dewatering: how many wells?
 4. Aquifer Recharge: well ID
 5. Monitoring: well ID
 6. Environmental Remediation: well ID
 7. Air Sparge Soil Vapor Extraction Recovery Injection

8. Oil Field Water Supply: lease
 9. Test Hole: well ID
 Cased Uncased Geotechnical
 10. Geothermal: how many bores?
 a) Closed Loop Horizontal Vertical
 b) Open Loop Surface Discharge Inj. of Water
 11. Other (specify):

Was a chemical/bacteriological sample submitted to KDHE? Yes No If yes, date sample was submitted:
 Water well disinfected? Yes No

8 TYPE OF CASING USED: Steel PVC Other CASING JOINTS: Girthed Clamped Welded Threaded
 Casing diameter 5 in. to 90 ft., Diameter in. to ft., Diameter in. to ft.
 Casing height above land surface 24 in. Weight SDR26 lbs./ft. Wall thickness or gauge No. 214
TYPE OF SCREEN OR PERFORATION MATERIAL:
 Steel Stainless Steel Fiberglass PVC Other (Specify)
 Brass Galvanized Steel Concrete tile None used (open hole)
SCREEN OR PERFORATION OPENINGS ARE:
 Continuous Slot Mill Slot Gauze Wrapped Torch Cut Drilled Holes Other (Specify)
 Louvered Shutter Key Punched Wire Wrapped Saw Cut None (Open Hole)
SCREEN-PERFORATED INTERVALS: From 50 ft. to 90 ft., From ft. to ft., From ft. to ft.
GRAVEL PACK INTERVALS: From ft. to ft., From ft. to ft., From ft. to ft.

9 GROUT MATERIAL: Neat cement Cement grout Bentonite Other
 Grout Intervals: From 0 ft. to 20 ft., From ft. to ft., From ft. to ft.
Nearest source of possible contamination:
 Septic Tank Lateral Lines Pit Privy Livestock Pens Insecticide Storage
 Sewer Lines Cess Pool Sewage Lagoon Fuel Storage Abandoned Water Well
 Watertight Sewer Lines Seepage Pit Feedyard Fertilizer Storage Oil Well/Gas Well
 Other (Specify)
 Direction from well? None Within 4 mi Distance from well? ft.

10 FROM	TO	LITHOLOGIC LOG	FROM	TO	LITHO. LOG (cont.) or PLUGGING INTERVALS
0	8	Top Soil + Clay			
8	10	lime Stone			
10	25	yellow shale			
25	73	Blue Shale			
73	74	Crumpled Shale + Water			
74	90	Gray Shale			

Notes:

11 CONTRACTOR'S OR LANDOWNER'S CERTIFICATION: This water well was constructed, reconstructed, or plugged under my jurisdiction and was completed on (mo-day-year) 7-2-15 and this record is true to the best of my knowledge and belief.
 Kansas Water Well Contractor's License No. 100 This Water Well Record was completed on (mo-day-year) 7-17-15
 under the business name of Backhoe Drilling

INSTRUCTIONS: Send one copy to WATER WELL OWNER and retain one copy for your records. Submit fee of \$5.00 for each constructed well along with one (white) copy to Kansas Department of Health and Environment, Bureau of Water, Geology Section, 1000 SW Jackson St., Suite 420, Topeka, Kansas 66612-1367. Telephone (785) 296-3565.