

1 LOCATION OF WATER WELL:		Fraction	Section Number	Township Number	Range Number
County:	Morris	SE 1/4	33	T 16 S	R 5 E/W


Distance and direction from nearest town or city street address of well if located within city?

1/2 miles South + 3 1/4 miles West of Delavan

2 WATER WELL OWNER: Biehler - Ecklund Farms, Inc.
RR#, St. Address, Box #: 1513 South 3000 Road
City, State, ZIP Code: Herington, KS 67449-5003

Board of Agriculture, Division of Water Resources
Application Number:

3 LOCATE WELL'S LOCATION WITH AN "X" IN SECTION BOX: 4 DEPTH OF COMPLETED WELL..... ft. ELEVATION:
 Depth(s) Groundwater Encountered 1..... ft 2..... ft 3..... ft

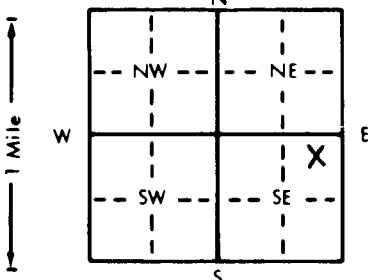

4 DEPTH OF COMPLETED WELL..... ft. ELEVATION:.....

Depth(s) Groundwater Encountered 1..... ft. 2..... ft. 3..... ft.

WELL'S STATIC WATER LEVEL..... ft. below land surface measured on mo/day/yr.....

Pump test data: Well water was..... ft. after..... hours pumping..... gpm

Est. Yield..... gpm: Well water was..... ft. after..... hours pumping..... gpm

Bore Hole Diameter..... in. to..... ft., and..... in. to..... ft.

WELL WATER TO BE USED AS:

1 Domestic	3 Feedlot	6 Oil field water supply	9 Dewatering	12 Other (Specify below)
2 Irrigation	4 Industrial	7 Lawn and garden only	10 Monitoring well	

Was a chemical/bacteriological sample submitted to Department? Yes.....No.....; If yes, mo/day/yr sample was submitted.....

Water Well Disinfected? Yes.....No.....

TYPE OF BLANK CASING USED:		3 Wrought iron	8 Concrete tile	CASING JOINTS: Glued Clamped	
1 Steel	3 RMP (SR)	6 Asbestos-Cement	9 Other (specify below)	Welded	
2 PVC	4 ABS	7 Fiberglass		Threaded.	
Blank casing diameter in. to ft., Dia in. to ft., Dia in. to ft.					
Casing height above land surface in., weight lbs./ft.		Wall thickness or gauge No.			
TYPE OF SCREEN OR PERFORATION MATERIAL:			7 PVC	10 Asbestos-cement	
1 Steel	3 Stainless steel	5 Fiberglass	8 RMP (SR)	11 Other (specify)	
2 Brass	4 Galvanized steel	6 Concrete tile	9 ABS	12 None used (open hole)	
SCREEN OR PERFORATION OPENINGS ARE:		5 Gauzed wrapped	8 Saw cut	11 None (open hole)	
1 Continuous slot	3 Mill slot	6 Wire wrapped	9 Drilled holes		
2 Louvered shutter	4 Key punched	7 Torch cut	10 Other (specify)		
SCREEN-PERFORATED INTERVALS:		From ft. to ft.,	From ft. to ft.,		
		From ft. to ft.,	From ft. to ft.,		
GRAVEL PACK INTERVALS:		From ft. to ft.,	From ft. to ft.,		
		From ft. to ft.,	From ft. to ft.,		

6 GROUT MATERIAL: 1 Neat cement 2 Cement grout 3 Bentonite 4 Other
Grout Intervals: From ft. to ft., From ft. to ft., From ft. to ft.
What is the nearest source of possible contamination:
1 Septic tank 4 Lateral lines 7 Pit privy 10 Livestock pens 14 Abandoned water well
2 Sewer lines 5 Cess pool 8 Sewage lagoon 11 Fuel storage 15 Oil well/Gas well
3 Watertight sewer lines 6 Seepage pit 9 Feedyard 12 Fertilizer storage 16 Other (specify below)
Direction from well? How many feet?

[illegible]

7. CONTRACTOR'S OR LANDOWNER'S CERTIFICATION: This water well was (1) constructed, (2) reconstructed, or (3) plugged under my jurisdiction and was completed on (mo/day/year) and this record is true to the best of my knowledge and belief. Kansas Water Well Contractor's License No. This Water Well Record was completed on (mo/day/yr) 11-1-01 under the business name of by (signature) *Jim Bickler*