

1 LOCATION OF WATER WELL: County: <u>Morris</u>	Fraction <u>Me 1/4 Me 1/4 NW 1/4</u>	Section Number <u>5</u>	Township Number T <u>16</u> S	Range Number R <u>5</u> E/W
--	---	----------------------------	----------------------------------	--------------------------------

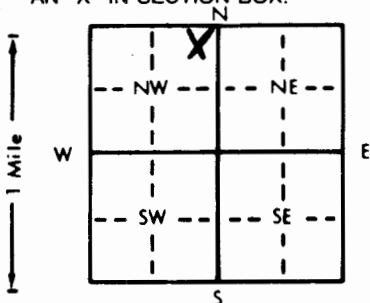
Distance and direction from nearest town or city street address of well if located within city?

1 1/2 W E 2 S N Herington2 WATER WELL OWNER: David BeckerRR#, St. Address, Box #: RR#City, State, ZIP Code: Herington, KS. 67449

Board of Agriculture, Division of Water Resources

Application Number:

3 LOCATE WELL'S LOCATION WITH AN "X" IN SECTION BOX:

4 DEPTH OF COMPLETED WELL: 135 ft.

ELEVATION:

Depth(s) Groundwater Encountered 1. 70 ft. 2. 128 ft. 3. 9-12-PRWELL'S STATIC WATER LEVEL 70 ft. below land surface measured on mo/day/yr

Pump test data: Well water was _____ ft. after _____ hours pumping _____ gpm

Est. Yield 30 gpm: Well water was _____ ft. after _____ hours pumping _____ gpmBore Hole Diameter 2 1/2 in. to 135 ft., and _____ in. to _____ ft.

WELL WATER TO BE USED AS: 5 Public water supply 8 Air conditioning 11 Injection well

1 Domestic 3 Feedlot 6 Oil field water supply 9 Dewatering 12 Other (Specify below)

2 Irrigation 4 Industrial 7 Lawn and garden only 10 Monitoring well

Was a chemical/bacteriological sample submitted to Department? Yes _____ No X; If yes, mo/day/yr sample was submittedWater Well Disinfected? Yes X No

5 TYPE OF BLANK CASING USED:

1 Steel 3 RMP (SR)

2 PVC 4 ABS

Blank casing diameter 5 in. to 105 ft. DiaCasing height above land surface 12 in. weight C1098/60 lbs./ft. Wall thickness or gauge No. 214

TYPE OF SCREEN OR PERFORATION MATERIAL:

1 Steel 3 Stainless steel

2 Brass 4 Galvanized steel

SCREEN OR PERFORATION OPENINGS ARE:

1 Continuous slot 3 Mill slot

2 Louvered shutter 4 Key punched

SCREEN-PERFORATED INTERVALS:

From 105 ft. to 135 ft. From _____ ft. to _____ ft.From 70 ft. to 135 ft. From _____ ft. to _____ ft.

GRAVEL PACK INTERVALS: From _____ ft. to _____ ft. From _____ ft. to _____ ft.

6 GROUT MATERIAL:

Grout Intervals: From 60 ft. to 70 ft. From 3 ft. to 23 ft. From _____ ft. to _____ ft.

What is the nearest source of possible contamination:

1 Septic tank 4 Lateral lines

2 Sewer lines 5 Cess pool

3 Watertight sewer lines 6 Seepage pit

7 Pit privy

8 Sewage lagoon

9 Feedyard

10 Livestock pens

11 Fuel storage

12 Fertilizer storage

13 Insecticide storage

14 Abandoned water well

15 Oil well/Gas well

16 Other (specify below)

Direction from well? NHow many feet? 75

FROM	TO	LITHOLOGIC LOG	FROM	TO	PLUGGING INTERVALS
0	4	Clay	100	115	Red Shale
4	16	Chime	115	128	Yellow Shale
16	24	Yellow Shale	128	129	Water
24	32	Gray Shale	129	135	Gray Rock
32	40	Chime			
40	52	Red Shale			
52	85	Chime & yellow Shale			
85	100	Blue Shale			

7 CONTRACTOR'S OR LANDOWNER'S CERTIFICATION: This water well was (1) constructed, (2) reconstructed, or (3) plugged under my jurisdiction and was completed on (mo/day/year) 9-12-88 and this record is true to the best of my knowledge and belief. KansasWater Well Contractor's License No. 120 This Water Well Record was completed on (mo/day/yr) 9-13-88under the business name of Backhus Drilling by (signature) Paul Backhus