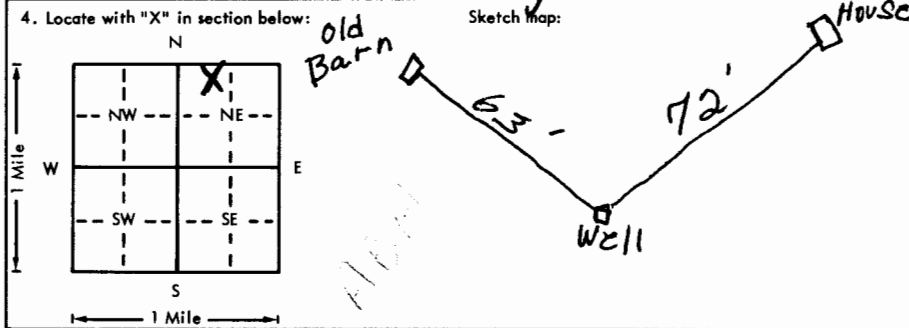


USE TYPEWRITER OR BALL POINT PEN-PRESS FIRMLY, PRINT CLEARLY.

WATER WELL RECORD
KSA 82a-1201-1215

Kansas Department of Health and Environment-Division of Environment
(Water well Contractors)
Topeka, Kansas 66620

1. Location of well: County Morris Fraction NE 1/4 NW 1/4 NE 1/4 Section number 20 Township number T 16 S R 5 E Range number 5	
2. Distance and direction from nearest town or city: 1 3/4 E 1 NS Street address of well location if in city: Herrington 3. Owner of well: Mrs Clara Fibrecht R.R. or street: 414 N. Bdwy City, state, zip code: Herrington Ks. 67449	
4. Locate with "X" in section below: Sketch map: 	
5. Type and color of material	
	From To
Top Soil	0 2
yellow clay	2 10
lime stone	10 27
Red shale	27 50
Gray shale + clay	50 65
lime stone	65 84
Red shale	84 105
Water	105
lime stone	105 116
(Use a second sheet if needed)	
18. Elevation:	19. Remarks:
Topography: <input type="checkbox"/> Hill <input checked="" type="checkbox"/> Slope <input checked="" type="checkbox"/> Upland <input type="checkbox"/> Valley	20. Water well contractor's certification: This well was drilled under my jurisdiction and this report is true to the best of my knowledge and belief. Baekhus Drilling 180 Business name: Jampa K.S. License No. _____ Address: Topeka Ks. Signed: Paul Baekhus Date: 1-9-76 Authorized representative

6. Bore hole dia. <u>7</u> in. Completion date <u>1-9-76</u> Well depth <u>116</u> ft.
7. <input checked="" type="checkbox"/> Cable tool <input type="checkbox"/> Rotary <input type="checkbox"/> Driven <input type="checkbox"/> Dug <input type="checkbox"/> Hollow rod <input type="checkbox"/> Jetted <input type="checkbox"/> Bored <input type="checkbox"/> Reverse rotary
8. Use: <input type="checkbox"/> Domestic <input type="checkbox"/> Public supply <input type="checkbox"/> Industry <input type="checkbox"/> Irrigation <input type="checkbox"/> Air conditioning <input checked="" type="checkbox"/> Stock <input type="checkbox"/> Lawn <input type="checkbox"/> Oil field water <input type="checkbox"/> Other
9. Casing: Material <u>PVC</u> Height <u>72</u> Above or below Threaded <input type="checkbox"/> Welded <input type="checkbox"/> Surface <u>72</u> in. RMP <u>PVC</u> Weight <u>160</u> lbs./ft. Dia. <u>5</u> in. to <u>116</u> ft. depth Wall Thickness: inches or Dia. <u> </u> in. to <u> </u> ft. depth gage No. <u>025</u>
10. Screen: Manufacturer's name <u>Certain-teed</u> Type <u>PVC</u> Dia. <u>5"</u> Slot/gauze <u>40</u> Length <u>75'</u> Set between <u>101</u> ft. and <u>116</u> ft. <u> </u> ft. and <u> </u> ft. Gravel pack? <input checked="" type="checkbox"/> Size range of material <u>30</u>
11. Static water level: <u>72</u> ft. below land surface Date <u>1-12-76</u> mo./day/yr.
12. Pumping level below land surfaces: <u> </u> ft. after <u> </u> hrs. pumping <u> </u> g.p.m. <u> </u> ft. after <u> </u> hrs. pumping <u> </u> g.p.m. Estimated maximum yield <u> </u> g.p.m.
13. Water sample submitted: <u> </u> mo./day/yr. Yes <input type="checkbox"/> No <input type="checkbox"/> Date <u> </u>
14. Well head completion: <u>Well House</u> <input type="checkbox"/> Pitless adapter <u> </u> inches above grade
15. Well grouted? <input checked="" type="checkbox"/> With: <input type="checkbox"/> Neat cement <input type="checkbox"/> Bentonite <input checked="" type="checkbox"/> Concrete Depth: From <u>0</u> ft. to <u>10</u> ft.
16. Nearest source of possible contamination <u>old milk</u> ft. <u> </u> Direction <u>NW</u> type <u>Barn</u> Well disinfected upon completion? <input checked="" type="checkbox"/> Yes <input type="checkbox"/> No
17. Pump: <input checked="" type="checkbox"/> Not installed Manufacturer's name <u> </u> Model number <u> </u> HP <u> </u> Volts <u> </u> Length of drop pipe <u> </u> ft. capacity <u> </u> g.p.m. Type: <input type="checkbox"/> Submersible <input type="checkbox"/> Turbine <input type="checkbox"/> Jet <input type="checkbox"/> Reciprocating <input type="checkbox"/> Centrifugal <input type="checkbox"/> Other

T 16 S R 5 E
 Sec 20 NE 1/4 NE 1/4

Forward the white, blue and pink copies to the Department of Health and Environment

Form WWC-5