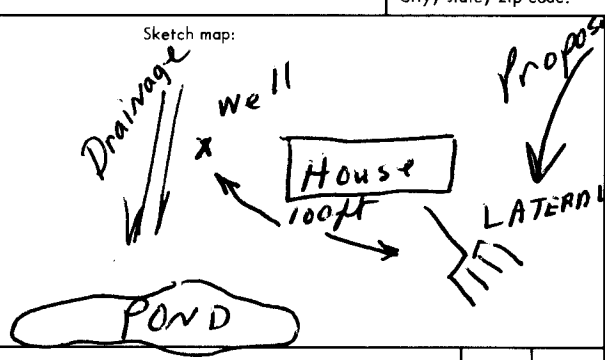


USE TYPEWRITER OR BALL
POINT PEN-PRESS FIRMLY,
PRINT CLEARLY.

WATER WELL RECORD
KSA 82a-1201-1215

Kansas Department of Health and
Environment-Division of Environment
(Water well Contractors)
Topeka, Kansas 66620

1. Location of well:	County Morris	Fraction SE 1/4 SW 1/4 SE 1/4	Section number 25	Township number T 16 S	Range number R 5 E
2. Distance and direction from nearest town or city: 2 mile South 1/4 west of Delevan			3. Owner of well: Roy Wiggins R.R. or street: RR1 City, state, zip code: Delevan KS		
4. Locate with "X" in section below: N W E S 1 Mile		Sketch map: 		6. Bore hole dia. 6 3/4 in. Completion date June 80 Well depth 77 ft. Top 13' B"	
5. Type and color of material		From	To	7. <input type="checkbox"/> Cable tool <input checked="" type="checkbox"/> Rotary <input type="checkbox"/> Driven <input type="checkbox"/> Dug <input type="checkbox"/> Hollow rod <input type="checkbox"/> Jetted <input type="checkbox"/> Bored <input type="checkbox"/> Reverse rotary	
Topsoil		0	3	8. Use: <input checked="" type="checkbox"/> Domestic <input type="checkbox"/> Public supply <input type="checkbox"/> Industry <input type="checkbox"/> Irrigation <input type="checkbox"/> Air conditioning <input type="checkbox"/> Stock <input type="checkbox"/> Lawn <input type="checkbox"/> Oil field water <input type="checkbox"/> Other	
Clay Yellow		3	6	9. Casing: Material P/KS Height: Above or below Threaded <input type="checkbox"/> Welded <input checked="" type="checkbox"/> Surface 18 in. RMP <input checked="" type="checkbox"/> PVC <input type="checkbox"/> Weight 200 lbs./ft. Dia. 5 in. to 50 ft. depth Wall Thickness: inches or Dia. 5 in. to 50 ft. depth gage No. 200	
LIME TAN		6	26	10. Screen: Manufacturer's name Sunflower Plastic Pipe Type RMP Dia. 5 Slot gauge 1/16 Length 27 Set between 50 ft. and 77 ft. 50 ft. and 77 ft. Gravel pack? NO Size range of material	
Shale Lite Pale Red		26	34	11. Static water level: 40 ft. below land surface Date June 17 80	
LIME TAN		34	36	12. Pumping level below land surfaces: ____ ft. after ____ hrs. pumping ____ g.p.m. ____ ft. after ____ hrs. pumping ____ g.p.m. Estimated maximum yield 20 g.p.m.	
Shale Blue Green		36	41	13. Water sample submitted: ____ mo./day/yr. <input type="checkbox"/> Yes <input checked="" type="checkbox"/> No Date	
Red Rock		41	50	14. Well head completion: <input type="checkbox"/> Pitless adapter 18 Inches above grade	
LIME TAN		50	53	15. Well grouted? Yes With: <input type="checkbox"/> Neat cement <input type="checkbox"/> Bentonite <input checked="" type="checkbox"/> Concrete Depth: From 3 ft. to 13 ft.	
Shale Gray		53	55	16. Nearest source of possible contamination: ft. 100 Direction SE Type Sewage Well disinfected upon completion? <input checked="" type="checkbox"/> Yes <input type="checkbox"/> No	
LIME Lite		55	77	17. Pump: <input checked="" type="checkbox"/> Not installed Manufacturer's name Model number ____ HP ____ Volts ____ Length of drop pipe ____ ft. capacity ____ g.p.m. Type: <input type="checkbox"/> Submersible <input type="checkbox"/> Turbine <input type="checkbox"/> Jet <input type="checkbox"/> Reciprocating <input type="checkbox"/> Centrifugal <input type="checkbox"/> Other	
(Use a second sheet if needed)				20. Water well contractor's certification: This well was drilled under my jurisdiction and this report is true to the best of my knowledge and belief. Zinn Water Well Drilling 210 Business name License No. Address West Springs, KS Signed Joseph A. Zinn Date Mar 81 Authorized representative	
18. Elevation:	19. Remarks:				
Topography: <input type="checkbox"/> Hill <input checked="" type="checkbox"/> Slope <input type="checkbox"/> Upland <input type="checkbox"/> Valley					

Forward the white, blue and pink copies to the Department of Health and Environment

Form WWC-5