WATER WELL RECORD Form WWC-5 KSA 82a-1212

1 LOCATION OF WATER WELL: County: MORRIS | Fraction: NW ¼ NW ¼ NE ¼ | Section Number: 25 | Township Number: T 16 S | Range Number: R 6 E W

Distance and direction from nearest town or city street address of well if located within city?
APPROXIMATELY 2 MILES WEST OF WILSEY, KS.

2 WATER WELL OWNER: MIKE & MELISSA GROVER
RR#, St. Address, Box # : ROUTE 1, BOX 19
City, State, ZIP Code : WILSEY, KS. 66873
Board of Agriculture, Division of Water Resources
Application Number: —

3 LOCATE WELL'S LOCATION WITH AN "X" IN SECTION BOX:

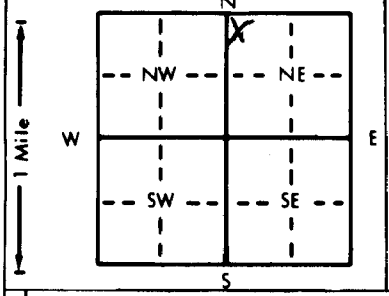

4 DEPTH OF COMPLETED WELL 102 ft. ELEVATION: —
Depth(s) Groundwater Encountered 1. 85 ft. 2. — ft. 3. — ft.
WELL'S STATIC WATER LEVEL 71 ft. below land surface measured on mo/day/yr MAY 5, 1999
Pump test data: Well water was — ft. after — hours pumping — gpm
Est. Yield 30+ gpm: Well water was — ft. after — hours pumping — gpm
Bore Hole Diameter 8.625 in. to 102 ft., and — in. to — ft.
WELL WATER TO BE USED AS: 1 Domestic 2 Irrigation 3 Feedlot 4 Industrial 5 Public water supply 6 Oil field water supply 7 Lawn and garden only 8 Air conditioning 9 Dewatering 10 Monitoring well 11 Injection well 12 Other (Specify below)
Was a chemical/bacteriological sample submitted to Department? Yes ..... No X ; If yes, mo/day/yr sample was submitted
Water Well Disinfected? Yes X No

5 TYPE OF BLANK CASING USED: 1 Steel 2 PVC 3 RMP (SR) 4 ABS 5 Wrought iron 6 Asbestos-Cement 7 Fiberglass 8 Concrete tile 9 Other (specify below)
CASING JOINTS: Glued X Clamped Welded Threaded
Blank casing diameter 5 in. to 82 ft., Dia — in. to — ft., Dia — in. to — ft.
Casing height above land surface 24 in., weight — lbs./ft. Wall thickness or gauge No. SDR 26

TYPE OF SCREEN OR PERFORATION MATERIAL: 7 PVC
1 Steel 2 Brass 3 Stainless steel 4 Galvanized steel 5 Fiberglass 6 Concrete tile 8 RMP (SR) 9 ABS 10 Asbestos-cement 11 Other (specify) 12 None used (open hole)

SCREEN OR PERFORATION OPENINGS ARE: 3 Mill slot
1 Continuous slot 2 Louvered shutter 3 Mill slot 4 Key punched 5 Gauzed wrapped 6 Wire wrapped 7 Torch cut 8 Saw cut 9 Drilled holes 10 Other (specify) 11 None (open hole)

SCREEN-PERFORATED INTERVALS: From 82 ft. to 102 ft., From — ft. to — ft.
From — ft. to — ft., From — ft. to — ft.
GRAVEL PACK INTERVALS: From 27 ft. to 102 ft., From — ft. to — ft.
From — ft. to — ft., From — ft. to — ft.

6 GROUT MATERIAL: 1 Neat cement 2 Cement grout 3 Bentonite 4 Other
Grout Intervals: From 0 ft. to 27 ft., From — ft. to — ft., From — ft. to — ft.

What is the nearest source of possible contamination:
1 Septic tank 2 Sewer lines 3 Watertight sewer lines 4 Lateral lines 5 Cess pool 6 Seepage pit 7 Pit privy 8 Sewage lagoon 9 Feedyard 10 Livestock pens 11 Fuel storage 12 Fertilizer storage 13 Insecticide storage 14 Abandoned water well 15 Oil well/Gas well 16 Other (specify below)
Direction from well? WEST How many feet? 150

FROM	TO	LITHOLOGIC LOG	FROM	TO	PLUGGING INTERVALS
0	7	SOIL			
7	21	SHALE, TAN			
21	26	SHALE, BROWN			
26	39	LIMESTONE, BROWN			
39	45	LIMESTONE TAN			
45	55	SHALE, GREEN GRAY			
55	95	LIMESTONE, GRAY			
95	102	SHALE, DK GRAY			
	102	TOTAL DEPTH			

7 CONTRACTOR'S OR LANDOWNER'S CERTIFICATION: This water well was (1) constructed, (2) reconstructed, or (3) plugged under my jurisdiction and was completed on (mo/day/year) 5/6/1999 and this record is true to the best of my knowledge and belief. Kansas Water Well Contractor's License No. 58 S This Water Well Record was completed on (mo/day/yr) MAY 6, 1999
under the business name of ASSOC. ENVIRON. INC. by (signature)

INSTRUCTIONS: Use typewriter or ball point pen. PLEASE PRESS FIRMLY and PRINT clearly. Please fill in blanks, underline or circle the correct answers. Send top three copies to Kansas Department of Health and Environment, Bureau of Water, Topeka, Kansas 66620-0001. Telephone: 913-296-5545. Send one to WATER WELL OWNER and retain one for your records.