


1 LOCATION OF WATER WELL: County: Morris Fraction: SW 1/4 NW 1/4 NW 1/4 Section Number: 22 Township Number: T 16 S Range Number: R 6 E

Distance and direction from nearest town or city street address of well if located within city?  
2 3/4 Mile East of 1/2 mile South of Delevan

2 WATER WELL OWNER: City of Wilsey  
 RR#, St. Address, Box #: \_\_\_\_\_  
 City, State, ZIP Code: \_\_\_\_\_  
 Board of Agriculture, Division of Water Resources  
 Application Number: \_\_\_\_\_

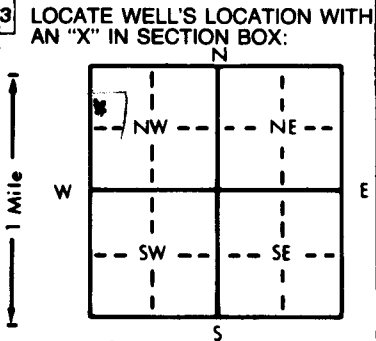

4 DEPTH OF COMPLETED WELL: Test Well ft. ELEVATION: \_\_\_\_\_  
 Depth(s) Groundwater Encountered 1. \_\_\_\_\_ ft. 2. \_\_\_\_\_ ft. 3. \_\_\_\_\_ ft.  
 WELL'S STATIC WATER LEVEL 64 ft. below land surface measured on mo/day/yr  
 Pump test data: Well water was 22 ft. after Several hours pumping 130 gpm  
 Est. Yield 130 + gpm; Well water was \_\_\_\_\_ ft. after \_\_\_\_\_ hours pumping \_\_\_\_\_ gpm  
 Bore Hole Diameter 6 1/2 in. to 110 ft., and \_\_\_\_\_ in. to \_\_\_\_\_ ft.  
 WELL WATER TO BE USED AS:  
 5 Public water supply 8 Air conditioning 11 Injection well  
 1 Domestic 3 Feedlot 6 Oil field water supply 9 Dewatering 12 Other (Specify below)  
 2 Irrigation 4 Industrial 7 Lawn and garden only 10 Monitoring well Test  
 Was a chemical/bacteriological sample submitted to Department? Yes \_\_\_\_\_ No \_\_\_\_\_; If yes, mo/day/yr sample was submitted \_\_\_\_\_  
 Water Well Disinfected? Yes \_\_\_\_\_ No \_\_\_\_\_

5 TYPE OF BLANK CASING USED: NONE  
 1 Steel 3 RMP (SR) 5 Wrought iron 8 Concrete tile CASING JOINTS: Glued \_\_\_\_\_ Clamped \_\_\_\_\_  
 2 PVC 4 ABS 6 Asbestos-Cement 9 Other (specify below) Welded \_\_\_\_\_  
 7 Fiberglass Threaded \_\_\_\_\_  
 Blank casing diameter NONE in. to \_\_\_\_\_ ft., Dia. \_\_\_\_\_ in. to \_\_\_\_\_ ft., Dia. \_\_\_\_\_ in. to \_\_\_\_\_ ft.  
 Casing height above land surface NONE in., weight \_\_\_\_\_ lbs./ft. Wall thickness or gauge No. \_\_\_\_\_  
 TYPE OF SCREEN OR PERFORATION MATERIAL: NONE  
 1 Steel 3 Stainless steel 5 Fiberglass 7 PVC 10 Asbestos-cement  
 2 Brass 4 Galvanized steel 6 Concrete tile 8 RMP (SR) 11 Other (specify) \_\_\_\_\_  
 12 None used (open hole)  
 SCREEN OR PERFORATION OPENINGS ARE: NONE  
 1 Continuous slot 3 Mill slot 5 Gauzed wrapped 8 Saw cut 11 None (open hole)  
 2 Louvered shutter 4 Key punched 6 Wire wrapped 9 Drilled holes  
 7 Torch cut 10 Other (specify) \_\_\_\_\_  
 SCREEN-PERFORATED INTERVALS: From NONE ft. to \_\_\_\_\_ ft., From \_\_\_\_\_ ft. to \_\_\_\_\_ ft.  
 From \_\_\_\_\_ ft. to \_\_\_\_\_ ft., From \_\_\_\_\_ ft. to \_\_\_\_\_ ft.  
 GRAVEL PACK INTERVALS: From NONE ft. to \_\_\_\_\_ ft., From \_\_\_\_\_ ft. to \_\_\_\_\_ ft.  
 From \_\_\_\_\_ ft. to \_\_\_\_\_ ft., From \_\_\_\_\_ ft. to \_\_\_\_\_ ft.

6 GROUT MATERIAL: 1 Neat cement 2 Cement grout 3 Bentonite 4 Other \_\_\_\_\_  
 Grout Intervals: From 3 ft. to 30 ft. From \_\_\_\_\_ ft. to \_\_\_\_\_ ft. From \_\_\_\_\_ ft. to \_\_\_\_\_ ft.  
 What is the nearest source of possible contamination: Temp Plug - For Drill out  
 1 Septic tank 4 Lateral lines 7 Pit privy 10 Livestock pens 14 Abandoned water well  
 2 Sewer lines 5 Cess pool 8 Sewage lagoon 11 Fuel storage 15 Oil well/Gas well  
 3 Watertight sewer lines 6 Seepage pit 9 Feedyard 12 Fertilizer storage 16 Other (specify below) \_\_\_\_\_  
 13 Insecticide storage \_\_\_\_\_  
 Direction from well? \_\_\_\_\_ How many feet? \_\_\_\_\_

| FROM | TO | LITHOLOGIC LOG            | FROM | TO  | PLUGGING INTERVALS                |
|------|----|---------------------------|------|-----|-----------------------------------|
| 0    | 4  | Top Soil BIK              | 79   | 80  | LIME Solid TAN                    |
| 4    | 10 | LIME Laminated Yel        | 80   | 85  | Shale TAN - Tested 17.34 gpm      |
| 12   | 14 | LIME Solid Yel            | 85   | 86  | LIME Gray                         |
| 14   | 18 | LIME Laminated Yel        | 86   | 95  | Shale Blue Green                  |
| 18   | 23 | LIME Solid Yel            | 95   | 101 | LIME Tested 26 gpm                |
| 23   | 28 | Shale Yel                 | 101  | 104 | Shale Lite                        |
| 28   | 30 | LIME Yel                  | 104  | 108 | LIME Frac White                   |
| 30   | 33 | Shale Yel                 | 108  | 110 | LIME Gray Hard                    |
| 33   | 34 | LIME Soft Yel             |      |     |                                   |
| 34   | 36 | Shale Yel Yel Water       |      |     |                                   |
| 36   | 39 | LIME Frac. Yel Lost       |      |     | Test Pump would only pump 130 gpm |
| 39   | 41 | Shale Soft Yel            |      |     |                                   |
| 41   | 55 | LIME Frac 1 cup/min       |      |     |                                   |
| 55   | 70 | Shale Red                 |      |     |                                   |
| 70   | 79 | LIME Frac TAN - 20' 3 gpm |      |     |                                   |

7 CONTRACTOR'S OR LANDOWNER'S CERTIFICATION: This water well was (1) constructed, (2) reconstructed, or (3) plugged under my jurisdiction and was completed on (mo/day/year) Aug 21 2001 and this record is true to the best of my knowledge and belief. Kansas Water Well Contractor's License No. 218 This Water Well Record was completed on (mo/day/yr) \_\_\_\_\_ under the business name of Zinn Water Well Dola by (signature) Joseph A. Zinn