


• **2577 "Q" Avenue (West of the Herington Municipal Airport)**

RR#, St. Address, Box # : 2577 "Q" Avenue
City, State, ZIP Code : Herington, KS 67449

Board of Agriculture, Division of Water Resources
Application Number:

4	DEPTH OF COMPLETED WELL	16	ft. ELEVATION:	1490.71 TOC
---	-------------------------	----	----------------	-------------

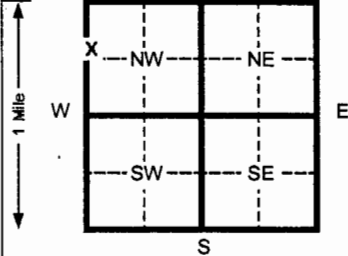

Depth(s) Groundwater Encountered 1 _____ ft. 2 _____ ft. 3 _____ ft.

WELL'S STATIC WATER LEVEL _____ ft. below land surface measured on mo/day/yr

Pump test data: Well water was _____ ft. after _____ hours pumping _____ gpm

Est. Yield _____ gpm: Well water was _____ ft. after _____ hours pumping _____ gpm

Bore Hole Diameter **8** in. to **16.1** ft. and _____ in. to _____ ft.

WELL WATER TO BE USED AS:

5 Public water supply	8 Air conditioning	11 Injection well		
1 Domestic	3 Feed lot	6 Oil field water supply	9 Dewatering	12 Other (Specify below)
2 Irrigation	4 Industrial	7 Lawn and garden (domestic)	10 Monitoring well	

Was a chemical/bacteriological sample submitted to Department? Yes _____ No **X** If yes, mo/day/yr sample was submitted _____

Water Well Disinfected? Yes _____ No **X**

(SR)	5 Wrought Iron	8 Concrete tile	CASING JOINTS: Glued _____ Clamped _____	
	6 Asbestos-Cement	9 Other (specify below)	Welded _____	
	7 Fiberglass		Threaded _____	Flush _____

Blank casing diameter	2	in. to	6	ft., Dia	in. to	ft., Dia	in. to	ft.
Casing height above land surface	36	in., weight	0.703	lbs./ft. Wall thickness or gauge No.	Sch. 40			

1 Steel	3 Stainless steel	5 Fiberglass	8 RMP (SR)	11 Other (specify) _____
2 Brass	4 Galvanized steel	6 Concrete tile	9 ABS	12 None used (open hole)

1 Continuous slot	3 Mill slot	6 Wire wrapped	9 Drilled holes
2 Louvered shutter	4 Key punched	7 Torch cut	10 Other (specify) _____

SCREEN-PERFORATED INTERVALS:	From	6	ft. to	16	ft. From		ft. to		ft.
	From		ft. to		ft. From		ft. to		ft.
GRAVEL PACK INTERVALS:	From	4	ft. to	16	ft. From		ft. to		ft.
	From		ft. to		ft. From		ft. to		ft.


6 GROUT MATERIAL:					
		1 Neat cement	2 Cement grout	3 Bentonite	4 Other _____
Grout Intervals	From	0.5 ft.	to	4 ft.	From _____ ft. to _____ ft.

1 Septic tank	4 Lateral lines	7 Pit privy	11 Fuel storage	15 Oil well/ Gas well
2 Sewer lines	5 Cess pool	8 Sewage lagoon	12 Fertilizer storage	16 Other (specify below)
3 Watertight sewer lines	6 Seepage pit	9 Feedyard	13 Insecticide storage	

Direction from well?

How many feet?

[illegible]

7 CONTRACTOR'S OR LANDOWNER'S CERTIFICATION: This water well was (1) constructed, (2) reconstructed, or (3) plugged under my jurisdiction and was completed on (mo/day/yr) 7-14-05 and this record is true to the best of my knowledge and belief. Kansas
Water Well Contractor's License No. 531 This Water Well Record was completed on (mo/day/yr) 7-18-05
under the business name of Geotechnical Services, Inc. bv (signature) 

INSTRUCTIONS: Please fill in blanks and circle the correct answers. Send three copies to Kansas Department of Health and Environment, Bureau of Water, 1000 S W Jackson St., Ste. 420, Topeka, Kansas 66612-1367. Telephone: 913-296-5545. Send one to WATER WELL OWNER and retain one for your records.