


1	LOCATION OF WATER WELL: County: Morris	Fraction SE 1/4 NE 1/4 NW 1/4	Section Number 6	Township Number T 10 S	Range Number R 6 E
Distance and direction from nearest town or city street address of well if located within city? MW-05A @ Tri County Public Airport, Herington KS					
2	WATER WELL OWNER: RR#, St. Address, Box # City, State, ZIP Code	Raytheon Company 870 Winter St. Westham MA			
Board of Agriculture, Division of Water Resources Application Number:					
3	LOCATE WELL'S LOCATION WITH AN "X" IN SECTION BOX: N E W S	4 DEPTH OF COMPLETED WELL 77.5	ft. ELEVATION: ft. ft. ft.		
Depth(s) Groundwater Encountered 1 ft. 2 ft. 3 ft. WELL'S STATIC WATER LEVEL ft. below land surface measured on mo/day/yr Pump test data: Well water was ft. after hours pumping gpm Est. Yield gpm: Well water was ft. after hours pumping gpm WELL WATER TO BE USED AS: 5 Public water supply 8 Air conditioning 11 Injection well 1 Domestic 3 Feedlot 6 Oil field water supply 9 Dewatering 12 Other (Specify below) 2 Irrigation 4 Industrial 7 Domestic (lawn & garden) 10 Monitoring well					
Was a chemical/bacteriological sample submitted to Department? Yes No If yes, mo/day/yr sample was submitted Water Well Disinfected? Yes X No O					
5	TYPE OF BLANK CASING USED: 1 Steel 3 RMP (SR) 2 PVC 4 ABS	5 Wrought iron 6 Asbestos-Cement 7 Fiberglass	8 Concrete tile 9 Other (specify below)	CASING JOINTS: Glued Clamped Welded Threaded X	
Blank casing diameter 10 in. to 30 ft., Dia 10 in. to 10.5 ft., Dia 2 in. to 77.5 ft.					
Casing height above land surface 30 in., weight lbs./ft. Wall thickness or guage No.					
TYPE OF SCREEN OR PERFORATION MATERIAL: 1 Steel 3 Stainless Steel 5 Fiberglass 8 RMP (SR) 2 Brass 4 Galvanized Steel 6 Concrete tile 9 ABS					
10 Asbestos-Cement 11 Other (Specify) 12 None used (open hole)					
SCREEN OR PERFORATION OPENINGS ARE: 1 Continuous slot 3 Mill slot 5 Guazed wrapped 8 Saw cut 11 None (open hole) 2 Louvered shutter 4 Key punched 6 Wire wrapped 7 Torch cut 9 Drilled holes 10 Other (specify) ft.					
SCREEN-PERFORATED INTERVALS: From 72 ft. to 77 ft., From ft. to ft. From ft. to ft., From ft. to ft.					
GRAVEL PACK INTERVALS: From 72 ft. to 77.5 ft., From ft. to ft. From ft. to ft., From ft. to ft.					
6	GROUT MATERIAL: 1 Neat cement Grout Intervals: From 0 ft. to 72 ft., From ft. to ft., From ft. to ft.	2 Cement grout	3 Bentonite	4 Other 10 Livestock pens 14 Abandoned water well 11 Fuel storage 15 Oil well/Gas well 12 Fertilizer storage 16 Other (specify below) product plume	
What is the nearest source of possible contamination: 1 Septic tank 4 Lateral lines 7 Pit privy 10 Livestock pens 2 Sewer lines 5 Cess pool 8 Sewage lagoon 11 Fuel storage 3 Watertight sewer lines 6 Seepage pit 9 Feedyard 12 Fertilizer storage 13 Insecticide storage How many feet?					
Direction from well?					
FROM	TO	LITHOLOGIC LOG	FROM	TO	PLUGGING INTERVALS
0	1.5	silt + clay	53	55	siltstone
1.5	10	clay	55	62	limestone
10	16	Siltstone	62	72.2	Shale
16	17	Shale	72.2	75.2	limestone
17	19.5	limestone	75.2	77.5	shale
19.5	22	siltstone			
22	34	Shale			
34	34.5	limestone			
34.5	36.5	Shale			
36.5	37	siltstone			
37	42.5	limestone			
42.5	43.5	Shale			
43.5	44	siltstone			
44	53	limestone			
7	CONTRACTOR'S OR LANDOWNER'S CERTIFICATION: This water well was 1 constructed, (2) reconstructed, or (3) plugged under my jurisdiction and was completed on (mo/day/year) 6/23/06 and this record is true to the best of my knowledge and belief. Kansas Water Well Contractor's Licence No 570 This Water Well Record was completed on (mo/day/yr) 6/11/07 by (signature) Jeff Jorgenson				
INSTRUCTIONS: Use typewriter or ball point pen. PLEASE PRESS FIRMLY and PRINT clearly. Please fill in blanks, underline or circle the correct answer. Send top three copies to Kansas Department of Health and Environment, Bureau of Water, Geology Section, 1000 SW Jackson St., Suite 420, Topeka, Kansas 66612-1367. Telephone 785-296-5522. Send one to WATER WELL OWNER and retain one for your records. Fee of \$5.00 for each constructed well.					

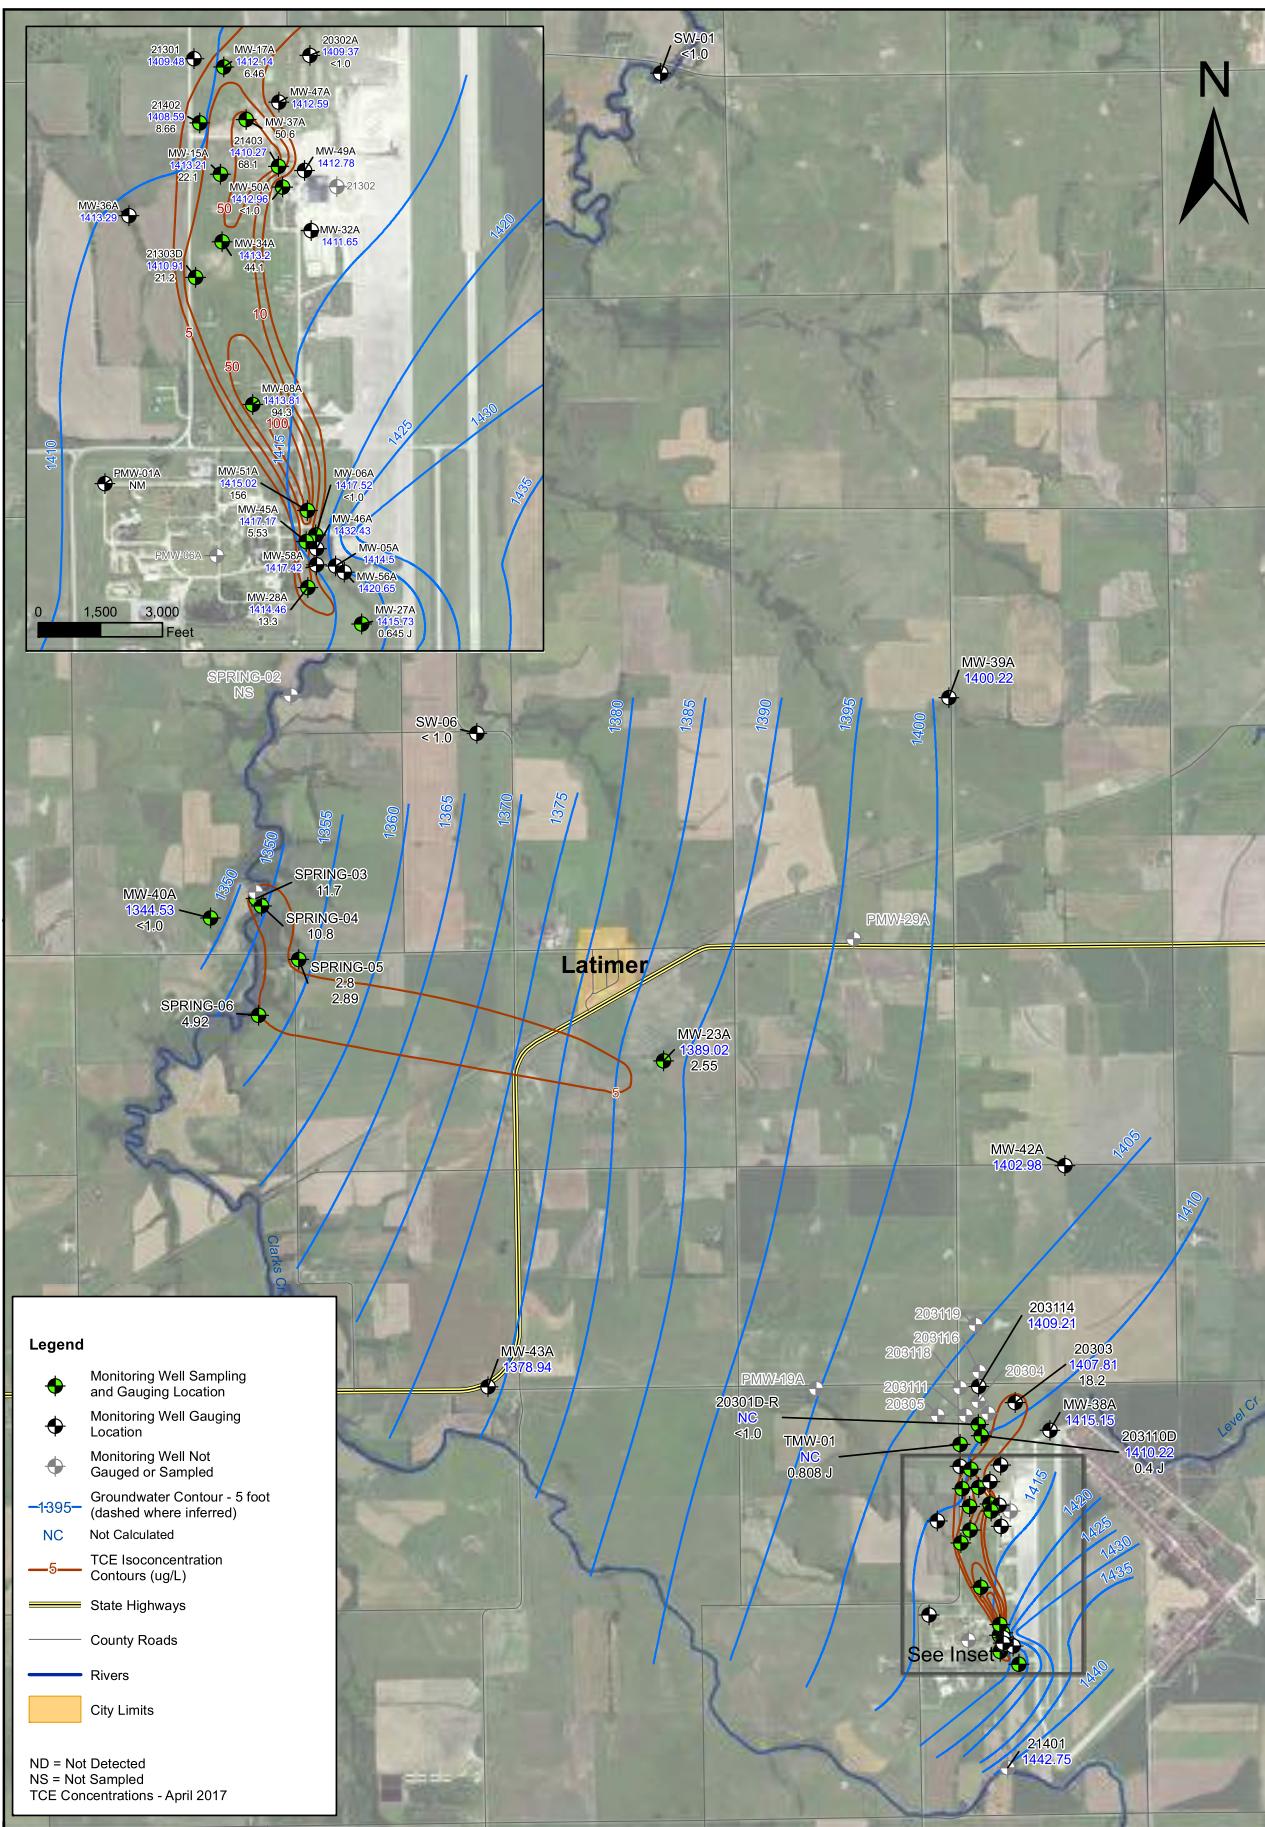

DESIGNED BY:	JKC	Stovall Water Bearing Unit Potentiometric Surface and Iso-Contour Map First Half 2017	Figure: 3
DRAWN BY:	JKC		
CHECKED BY:	JW		
APPROVED BY			
DATE:	05/10/2017	ESSENTIAL MANAGEMENT SOLUTIONS	0 3,000 6,000 Feet 1" = 3000'