


1 LOCATION OF WATER WELL: County: Morris Fraction: SW 1/4 NE 1/4 SW 1/4 Section Number: 18 Township Number: T 16 S Range Number: R 6 B/W

Distance and direction from nearest town or city street address of well if located within city?
1/2 block North intersection of Hiway 56 and main street Delavan, KS.

2 WATER WELL OWNER: Mike Gibson
 RR#, St. Address, Box #: Route 1 Box 96
 City, State, ZIP Code: Herington, KS 67449
 Board of Agriculture, Division of Water Resources
 Application Number:

3 LOCATE WELL'S LOCATION WITH AN "X" IN SECTION BOX:

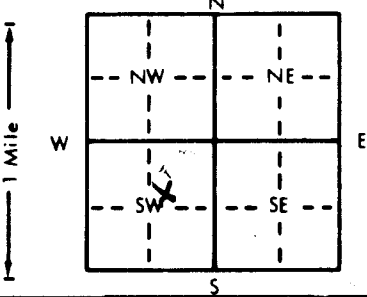

4 DEPTH OF COMPLETED WELL: 116 ft. ELEVATION:
 Depth(s) Groundwater Encountered 1. 80 ft. 2. 105 ft. 3. _____ ft.
 WELL'S STATIC WATER LEVEL: 50 ft. below land surface measured on mo/day/yr 4-1-90
 Pump test data: Well water was 40 ft. after 1/2 hours pumping 30 gpm
 Est. Yield: 20 gpm; Well water was _____ ft. after _____ hours pumping _____ gpm
 Bore Hole Diameter: 8 in. to 12 1/2 in. and _____ in. to _____ in.
 WELL WATER TO BE USED AS:
 1 Domestic 3 Feedlot 6 Oil field water supply 9 Dewatering 12 Other (Specify below)
 2 Irrigation 4 Industrial 7 Lawn and garden only 10 Monitoring well
 Was a chemical/bacteriological sample submitted to Department? Yes _____ No _____; If yes, mo/day/yr sample was submitted
 Water Well Disinfected? Yes No

5 TYPE OF CASING USED:
 1 Steel 3 RMP (SR) 5 Wrought iron 8 Concrete tile CASING JOINTS: Glued Clamped
 2 PVC 4 ABS 6 Asbestos-Cement 9 Other (specify below) Welded
 _____ 7 Fiberglass _____ Threaded

Blank casing diameter: 5 in. to 11 1/2 in. Dia. _____ in. to _____ in. Dia. _____ in. to _____ in. Dia.
 Casing height above land surface: 16 in., weight SDR-26 lbs./ft. Wall thickness or gauge No. _____

TYPE OF SCREEN OR PERFORATION MATERIAL:
 1 Steel 3 Stainless steel 5 Fiberglass 8 RMP (SR) 10 Asbestos-cement
 2 Brass 4 Galvanized steel 6 Concrete tile 9 ABS 11 Other (specify) _____
 _____ 12 None used (open hole)

SCREEN OR PERFORATION OPENINGS ARE:
 1 Continuous slot 3 Mill slot 5 Gauzed wrapped 8 Saw cut 11 None (open hole)
 2 Louvered shutter 4 Key punched 6 Wire wrapped 9 Drilled holes
 _____ 7 Torch cut 10 Other (specify) _____

SCREEN-PERFORATED INTERVALS: From 60 ft. to 116 ft., From _____ ft. to _____ ft.
 From _____ ft. to _____ ft., From _____ ft. to _____ ft.
 GRAVEL PACK INTERVALS: From 70 ft. to 116 ft., From _____ ft. to _____ ft.
 From _____ ft. to _____ ft., From _____ ft. to _____ ft.

6 GROUT MATERIAL: 1 Neat cement 2 Cement grout 3 Bentonite 4 Other _____
 Grout Intervals: From 2 1/2 ft. to 23 ft., From _____ ft. to _____ ft., From _____ ft. to _____ ft.

What is the nearest source of possible contamination:
 Septic tank 4 Lateral lines 7 Pit privy 10 Livestock pens 14 Abandoned water well
 2 Sewer lines 5 Cess pool 8 Sewage lagoon 11 Fuel storage 15 Oil well/Gas well
 3 Watertight sewer lines 6 Seepage pit 9 Feedyard 12 Fertilizer storage 16 Other (specify below)
 _____ 13 Insecticide storage
 Direction from well? _____ How many feet? 100

FROM	TO	LITHOLOGIC LOG	FROM	TO	PLUGGING INTERVALS
0	80	Remove and drill thru old casing			
80	90	gray shale			
90	100	gray shale, fine sand			
100	105	gray shale			
105	115	fine sand			
115	121	" "			
121	TD	Hard rock			

7 CONTRACTOR'S OR LANDOWNER'S CERTIFICATION: This water well was (1) constructed, (2) reconstructed, or (3) plugged under my jurisdiction and was completed on (mo/day/year) 5-4-90 and this record is true to the best of my knowledge and belief. Kansas Water Well Contractor's License No. 513 This Water Well Record was completed on (mo/day/year) 6-1-90 under the business name of Had Drilling Service by (signature) Mary Schneider