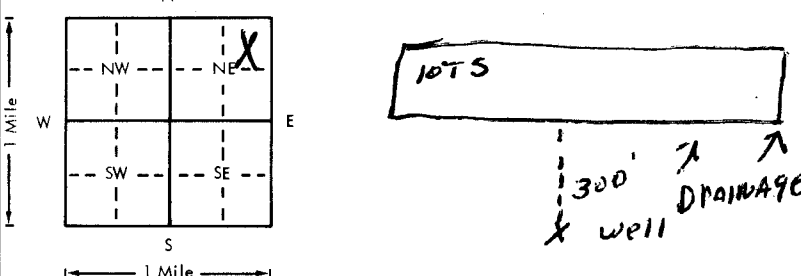


USE TYPEWRITER OR BALL POINT PEN-PRESS FIRMLY, PRINT CLEARLY.

WATER WELL RECORD  
KSA 82a-1201-1215

Kansas Department of Health and Environment-Division of Environment (Water well Contractors) Topeka, Kansas 66620

1. Location of well: County <b>MORRIS</b> Fraction <b>NE 1/4 NE 1/4 NE 1/4</b> Section number <b>5</b> Township number <b>T 16 S R 6 E/W</b> Range number	
2. Distance and direction from nearest town or city: <b>3 1/2 MI E OF DELAWARE</b> Street address of well location if in city: <b>DELAWARE</b> 3. Owner of well: <b>TRI COUNTY FEED LOT</b> R.R. or street: City, state, zip code: <b>BOX 307 HERRINGTON 67449</b>	
4. Locate with "X" in section below: Sketch map: 	
5. Type and color of material	
	From To
Top soil	0 9
Clay brown	9 22
shale, grey, Red, yellow	22 110
Limestone, yellow, water bearing	110 118
Limestone grey	118 160
(Use a second sheet if needed)	
18. Elevation:	19. Remarks: <b>OWNER TO INSTALL SLOB</b>
Topography: <input checked="" type="checkbox"/> Hill <input type="checkbox"/> Slope <input type="checkbox"/> Upland <input type="checkbox"/> Valley	20. Water well contractor's certification: This well was drilled under my jurisdiction and this report is true to the best of my knowledge and belief. <b>Stader Drilling Co Inc 182</b> Business name License No. Address <b>RT 1 Holton, KS</b> Signed <b>Dale Robson</b> Date <b>6-23-79</b> Authorized representative

6. Bore hole dia. <b>12</b> in. Completion date <b>6-22-79</b> Well depth <b>160</b> ft.	
7. <input checked="" type="checkbox"/> Cable tool <input checked="" type="checkbox"/> Rotary <input type="checkbox"/> Driven <input type="checkbox"/> Dug <input type="checkbox"/> Hollow rod <input type="checkbox"/> Jetted <input type="checkbox"/> Bored <input type="checkbox"/> Reverse rotary	
8. Use: <input type="checkbox"/> Domestic <input type="checkbox"/> Public supply <input type="checkbox"/> Industry <input type="checkbox"/> Irrigation <input type="checkbox"/> Air conditioning <input checked="" type="checkbox"/> Stock <input type="checkbox"/> Lawn <input type="checkbox"/> Oil field water <input type="checkbox"/> Other	
9. Casing: Material <b>PVC</b> Height: <b>Above</b> or below Threading: <b>Welded</b> Surface <b>34</b> in. RMP: <b>PVC 9L</b> Weight <b>350</b> lbs./ft. Dia. <b>8</b> in. to <b>160</b> ft. depth Wall Thickness: inches or Dia. in. to ft. depth gage No. <b>332</b>	
10. Screen: Manufacturer's name <b>PUMPO MPI</b> Type <b>PVC</b> Dia. <b>8</b> Slot/gauze <b>.060</b> Length <b>70</b> Set between <b>70</b> ft. and <b>140</b> ft. Gravel pack? <input checked="" type="checkbox"/> Size range of material <b>1/4 x 1/8</b>	
11. Static water level: <b>70</b> ft. below land surface Date <b>6-22-79</b> mo./day/yr.	
12. Pumping level below land surfaces: _____ ft. after _____ hrs. pumping _____ g.p.m. Estimated maximum yield <b>140</b> g.p.m.	
13. Water sample submitted: _____ mo./day/yr. Yes <input checked="" type="checkbox"/> No <input type="checkbox"/> Date	
14. Well head completion: <b>CAP</b> Pitless adapter <b>29</b> inches above grade	
15. Well grouted? <input checked="" type="checkbox"/> With: <input checked="" type="checkbox"/> Neat cement <input type="checkbox"/> Bentonite <input type="checkbox"/> Concrete Depth: From <b>0</b> ft. to <b>20</b> ft.	
16. Nearest source of possible contamination: ft. <b>300</b> Direction <b>N</b> Type <b>LOTS</b> Well disinfected upon completion? <input checked="" type="checkbox"/> Yes <input type="checkbox"/> No	
17. Pump: <input checked="" type="checkbox"/> Not installed Manufacturer's name _____ Model number _____ HP _____ Volts _____ Length of drop pipe _____ ft. capacity _____ g.p.m. Type: <input type="checkbox"/> Submersible <input type="checkbox"/> Turbine <input type="checkbox"/> Jet <input type="checkbox"/> Reciprocating <input type="checkbox"/> Centrifugal <input type="checkbox"/> Other	

T 16 S R 6 E W 5 NE NE NE