


1 LOCATION OF WATER WELL: County: Morris Fraction: NE 1/4 NE 1/4 NE 1/4 Section Number: 10 Township Number: T 16 S Range Number: R 6 E

Distance and direction from nearest town or city street address of well if located within city?
3 3/4 E and 1 3/4 N of Delevan

2 WATER WELL OWNER: Colonel Hutchinson
 RR#, St. Address, Box #: 12 B Forsyth Ave
 City, State, ZIP Code: Font Riley 66442
 Board of Agriculture, Division of Water Resources
 Application Number: _____

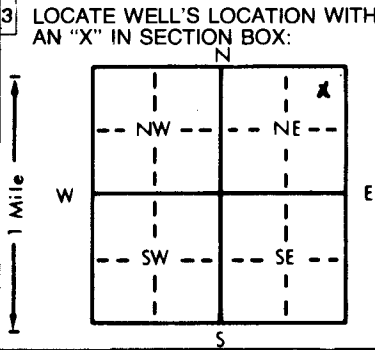

4 DEPTH OF COMPLETED WELL: 96 ft. ELEVATION: _____
 Depth(s) Groundwater Encountered: 1. 59 ft. 2. _____ ft. 3. _____ ft.
 WELL'S STATIC WATER LEVEL: 55 ft. below land surface measured on mo/day/yr 10 May 83
 Pump test data: Well water was _____ ft. after _____ hours pumping _____ gpm
 Est. Yield: 207 gpm; Well water was _____ ft. after _____ hours pumping _____ gpm
 Bore Hole Diameter: 8 in. to 9 1/4 in. and _____ in. to _____ in.
 WELL WATER TO BE USED AS:
 Domestic Feedlot Oil field water supply Dewatering 12 Other (Specify below)
 2 Irrigation 4 Industrial 7 Lawn and garden only 10 Observation well
 Was a chemical/bacteriological sample submitted to Department? Yes No
 If yes, mo/day/yr sample was submitted _____
 Water Well Disinfected? Yes No

5 TYPE OF BLANK CASING USED:
 1 Steel 3 RMP (SR) 5 Wrought iron 8 Concrete tile CASING JOINTS: Glued Clamped
 2 PVC 4 ABS 6 Asbestos-Cement 9 Other (specify below) Welded
 _____ 7 Fiberglass _____ _____ Threaded
 Blank casing diameter: 5 in. to 50 ft. Dia _____ in. to _____ ft. Dia _____ in. to _____ ft.
 Casing height above land surface: 18 in. weight _____ lbs./ft. Wall thickness or gauge No. 214
 TYPE OF SCREEN OR PERFORATION MATERIAL:
 1 Steel 3 Stainless steel 5 Fiberglass 7 PVC 10 Asbestos-cement
 2 Brass 4 Galvanized steel 6 Concrete tile 8 RMP (SR) 11 Other (specify) _____
 _____ _____ _____ _____ 12 None used (open hole)
 SCREEN OR PERFORATION OPENINGS ARE:
 1 Continuous slot 3 Mill slot 5 Gauzed wrapped 8 Saw cut 11 None (open hole)
 2 Louvered shutter 4 Key punched 6 Wire wrapped 9 Drilled holes
 _____ _____ _____ _____ _____
 SCREEN-PERFORATED INTERVALS: From 50 ft. to 96 ft. From _____ ft. to _____ ft.
 GRAVEL PACK INTERVALS: From _____ ft. to _____ ft. From _____ ft. to _____ ft.

6 GROUT MATERIAL: 1 Neat cement 2 Cement grout 3 Bentonite 4 Other
 Grout Intervals: From 3 ft. to 13 ft. From _____ ft. to _____ ft.
 What is the nearest source of possible contamination:
 1 Septic tank 4 Lateral lines 7 Pit privy 10 Livestock pens 14 Abandoned water well
 2 Sewer lines 5 Cess pool 8 Sewage lagoon 11 Fuel storage 15 Oil well/Gas well
 3 Watertight sewer lines 6 Seepage pit 9 Feedyard 12 Fertilizer storage 16 Other (specify below)
 _____ _____ _____ _____ _____
 Direction from well? North How many feet? 75' Proposed

FROM	TO	LITHOLOGIC LOG	FROM	TO	LITHOLOGIC LOG
0	1	Top soil	59	63	LIME & Flint
1	6	Clay Lite Brn to Red	63	66	LIME
6	6 1/2	Lime soft Yel	66	69	Shale Blue
6 1/2	7	Shale Yel	69	89	Flint & LIME
7	9	LIME Soft	89	92	LIME
9	11	Red Rock	92	96	Flint & LIME
11	12	LIME			
12	24	Red Rock			
24	25	LIME Yel			
25	28	Shale Green			
28	31	LIME Yel			
31	44	Solid LIME Gray			
44	51	Shale Green			
51	55	LIME, Lite Gray			
55	59	Fractured LIME			

7 CONTRACTOR'S OR LANDOWNER'S CERTIFICATION: This water well was constructed, reconstructed, or plugged under my jurisdiction and was completed on (mo/day/year) MAY 10 83 and this record is true to the best of my knowledge and belief. Kansas Water Well Contractor's License No. 218 This Water Well Record was completed on (mo/day/yr) 26 June 83 under the business name of Zinn Water Well Dring by (signature) Joseph A. Zinn

INSTRUCTIONS: Use typewriter or ball point pen, PLEASE PRESS FIRMLY and PRINT clearly. Please fill in blanks, underline or circle the correct answers. Send top three copies to Kansas Department of Health and Environment, Division of Environment, Environmental Geology Section, Topeka, KS 66620. Send one to WATER WELL OWNER and retain one for your records.

OFFICE USE ONLY T 16 R 6 E 1/4 NE 1/4 NE 1/4 NE 1/4