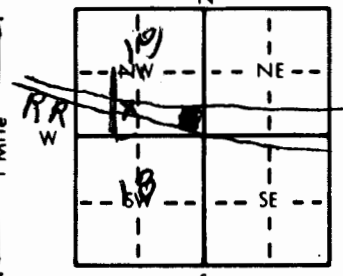


1 LOCATION OF WATER WELL: County: **MORRIS** Fraction: **SE 1/4 SE 1/4 NW 1/4** Section Number: **18** Township Number: **T 16 S** Range Number: **R 6 E**

Distance and direction from nearest town or city street address of well if located within city?  
**IN DELLVAN LOT 7-12 BLOCK 17**

2 WATER WELL OWNER: **REX & PEGGY LEE**  
 RR#, St. Address, Box #: **RR1 BOX 106**  
 City, State, ZIP Code: **66047 DELAVAN KS**  
 Board of Agriculture, Division of Water Resources  
 Application Number:

3 LOCATE WELL'S LOCATION WITH AN "X" IN SECTION BOX:  


4 DEPTH OF COMPLETED WELL: **136** ft. ELEVATION:  
 Depth(s) Groundwater Encountered: **1.00** ft. 2. ft. 3. ft.  
 WELL'S STATIC WATER LEVEL: ft. below land surface measured on mo/day/yr  
 Pump test data: Well water was ft. after hours pumping gpm  
 Est. Yield: **15** gpm: Well water was ft. after hours pumping gpm  
 Bore Hole Diameter: **8** in. to ft., and in. to ft.  
 WELL WATER TO BE USED AS:  
 Domestic  Feedlot  Oil field water supply  Dewatering  Other (Specify below)  
 Irrigation  Industrial  Lawn and garden only  Observation well  
 Was a chemical/bacteriological sample submitted to Department? Yes No  If yes, mo/day/yr sample was submitted  
 Water Well Disinfected? Yes  No

5 TYPE OF BLANK CASING USED:  
 1 Steel  3 RMP (SR)  5 Wrought iron  8 Concrete tile CASING JOINTS:  Glued  Clamped  
 2 PVC  4 ABS  6 Asbestos-Cement  9 Other (specify below)  Welded  
 7 Fiberglass  Threaded

Blank casing diameter: **5** in. to **100** ft., Dia. in. to ft., Dia. in. to ft.  
 Casing height above land surface: **14** in., weight lbs./ft. Wall thickness or gauge No. **160**

TYPE OF SCREEN OR PERFORATION MATERIAL:  
 1 Steel  3 Stainless steel  5 Fiberglass  7 PVC  10 Asbestos-cement  
 2 Brass  4 Galvanized steel  6 Concrete tile  8 RMP (SR)  11 Other (specify)  
 12 None used (open hole)

SCREEN OR PERFORATION OPENINGS ARE:  
 1 Continuous slot  3 Mill slot  5 Gauzed wrapped  7 Saw cut  11 None (open hole)  
 2 Louvered shutter  4 Key punched  6 Wire wrapped  9 Drilled holes  
 7 Torch cut  10 Other (specify)

SCREEN-PERFORATED INTERVALS: From **100** ft. to **136** ft., From ft. to ft.  
 GRAVEL PACK INTERVALS: From ft. to ft., From ft. to ft.

6 GROUT MATERIAL:  1 Neat cement  2 Cement grout  3 Bentonite  4 Other  
 Grout Intervals: From **0** ft. to **20** ft., From ft. to ft., From ft. to ft.

What is the nearest source of possible contamination:  
 1 Septic tank  4 Lateral lines  7 Pit privy  10 Livestock pens  14 Abandoned water well  
 2 Sewer lines  5 Cess pool  8 Sewage lagoon  11 Fuel storage  15 Oil well/Gas well  
 3 Watertight sewer lines  6 Seepage pit  9 Feedyard  12 Fertilizer storage  16 Other (specify below)  
 13 Insecticide storage  
 Direction from well? How many feet? **200 ft SE**

FROM	TO	LITHOLOGIC LOG	FROM	TO	LITHOLOGIC LOG
0	5	BLACK DIAT			
5	37	ROCK YELLOW			
37	45	SHALE RED			
45	55	SHALE BLUE			
55	65	LIME ROCK GRAY			
65	75	LIME ROCK YELLOW			
75	90	LIME ROCK GRAY			
90	100	SHALE BLUE			
100	105	SHALE RED			
105	110	SHALE LT RED			
110	115	SHALE RED			
115	120	SHALE RED			
120	125	SHALE DARK			
125	130	SHALE BLUE			
130	136	SHALE BLUE			

7 CONTRACTOR'S OR LANDOWNER'S CERTIFICATION: This water well was  (1) constructed,  (2) reconstructed, or  (3) plugged under my jurisdiction and was completed on (mo/day/year) **Aug 20-1988** and this record is true to the best of my knowledge and belief. Kansas Water Well Contractor's License No. **156** This Water Well Record was completed on (mo/day/yr) **Sept 15-1988** under the business name of **L. Hoffmann** by (signature) **L. Hoffmann**

INSTRUCTIONS: Use typewriter or ball point pen, PLEASE PRESS FIRMLY and PRINT clearly. Please fill in blanks, underline or circle the correct answers. Send top three copies to Kansas Department of Health and Environment, Division of Environment, Environmental Geology Section, Topeka, KS 66620. Send one to WATER WELL OWNER and retain one for your records.

OFFICE USE ONLY