USE TYPEWRITER OR BALL POINT PEN-PRESS FIRMLY, PRINT CLEARLY.

WATER WELL RECORD
KSA 82a-1201-1215

Kansas Department of Health and Environment-Division of Environment
(Water well Contractors)
Topeka, Kansas 66620

1. Location of well:	County	Fraction	Section number	Township number	Range number
	Morris	NW 1/4 SE 1/4 SW 1/4	18	T 16 S	R 6 (E) W

2. Distance and direction from nearest town or city: East edge of Delevan, Kan
Street address of well location if in city: Delevan, Kan

3. Owner of well: Bill Bruckner
R.R. or street:
City, state, zip code: Delevan, Kan

4. Locate with "X" in section below:

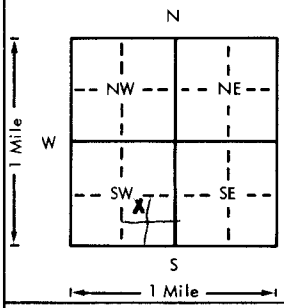

Sketch map:

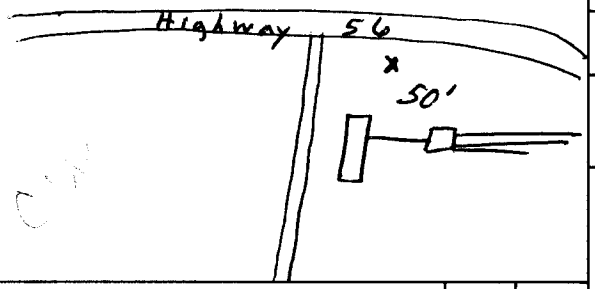

5. Type and color of material	From	To
FILL	0	7
LIME YELLOW 2'	7	9
SHALE YELLOW 6'	9	15
LIME YELLOW 3'	15	18
SHALE YELLOW 7'	18	25
LIME YELLOW 2'	25	27
SHALE YELLOW 1'	27	28
LIME WHITE 1'	28	29
SHALE LITE BLUE 4'	29	33
RED ROCK 8'	33	41
SHALE LITE BLUE 3'	41	44
LIME WHITE 5'	44	49
SHALE GRAY 1'	49	50
LIME WHITE 1'	50	51
SHALE GRAY 3'	51	54
LIME WHITE 13'	54	67
SHALE GRAY 10'	67	77
LIME WHITE 1'	77	81
SHALE LITE 8'	81	89
LIME LITE 1'	89	90
SHALE BLUE GREEN 8'	90	98
LIME LITE 1'	98	99
RED ROCK 10'	99	109
SHALE GREEN 7'	109	116
SHALE BLUE 3'	116	119
LIME DARK GRAY 11'	119	130

(Use a second sheet if needed)

6. Bore hole dia. 6 3/4 in. Completion date 4-6-78
Well depth 130 ft.

7. __ Cable tool X Rotary __ Driven __ Dug
__ Hollow rod __ Jetted __ Bored __ Reverse rotary

8. Use: X Domestic __ Public supply __ Industry
__ Irrigation __ Air conditioning __ Stock
__ Lawn __ Oil field water __ Other

9. Casing: Material PVC Height (Above) or below
Threaded ___ Welded ___ Surface 18 in.
RMP X PVC ___ Weight ___ lbs./ft.
Dia. 5 in. to 70 ft. depth Wall Thickness: inches or
Dia. ___ in. to ___ ft. depth gage No. 200

10. Screen: Manufacturer's name Sunflower Plastics
Type AMP Dia. 5"
(Slot)/gauze 18 Length 60'
Set between 70 ft. and 130 ft.
___ ft. and ___ ft.
Gravel pack? Yes Size range of material 1/8 - 3/8

11. Static water level: mo./day/yr.
70 ft. below land surface Date 4-6-78

12. Pumping level below land surfaces:
___ ft. after ___ hrs. pumping ___ g.p.m.
___ ft. after ___ hrs. pumping ___ g.p.m.
Estimated maximum yield 15 g.p.m.

13. Water sample submitted: mo./day/yr.
__ Yes X No Date —

14. Well head completion:
__ Pitless adapter 18 Inches above grade

15. Well grouted? Yes
With: ___ Neat cement ___ Bentonite X Concrete
Depth: From 4 ft. to 14 ft. See Remark

16. Nearest source of possible contamination:
ft. 50 Direction SE Type Septic
Well disinfected upon completion? X Yes ___ No

17. Pump: X Not installed
Manufacturer's name
Model number ___ HP ___ Volts ___
Length of drop pipe ___ ft. capacity ___ g.p.m.
Type:
__ Submersible __ Turbine
__ Jet __ Reciprocating
__ Centrifugal __ Other

18. Elevation:

Topography:
__ Hill
__ Slope
X Upland
__ Valley

19. Remarks: We cemented off shallow water that is not useable from 40-48 ft
Concrete slab to be installed by CUSTOMER

20. Water well contractor's certification:
This well was drilled under my jurisdiction and this report is true to the best of my knowledge and belief.
ZINN Water Well Drilling 218
Business name License No.
Address Lost Springs, Kan
Signed Joseph A. Zinn Date 4-10-78
Authorized representative

T 16 — R 6 (E) W
Sec 18
1/4 NW 1/4 SE 1/4 SW 1/4

Forward the white, blue and pink copies to the Department of Health and Environment

Form WWC-5

MI-1023